


REPLACEMENT OF PUMPS AND PUMP MOTORS

AT FIVE NETC BOQ BUILDINGS FOR NAVAL EDUCATION AND TRAINING CENTER NEWPORT, RHODE ISLAND

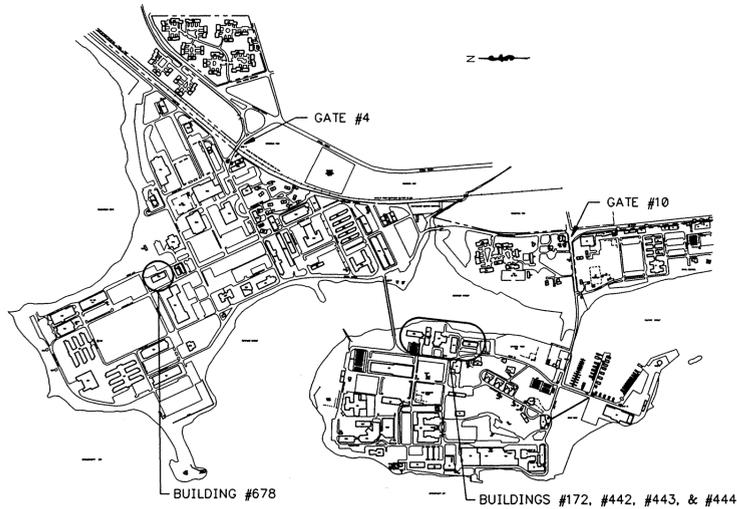

LOCATION MAP

SCALE: A 0 400 800 1200
GRAPHIC SCALE IN FEET

| INDEX OF DRAWINGS | | | |
|-------------------|---------------|--------------|---|
| SHEET NO. | NETC DWG. NO. | N.A.V.F.A.C. | TITLE |
| 1 | 31311-309 | 2171783 | TITLE SHEET |
| 2 | 31312-309 | 2171784 | MECHANICAL ROOM PLAN - BUILDING #172 |
| 3 | 31313-309 | 2171785 | MECHANICAL ROOM PLAN - BUILDING #442 |
| 4 | 31314-309 | 2171786 | MECHANICAL ROOM PLAN - BUILDING #443 |
| 5 | 31315-309 | 2171787 | MECHANICAL ROOM PLAN - BUILDING #444 |
| 6 | 31316-309 | 2171788 | MECHANICAL ROOM PLAN - BUILDING #678 |
| 7 | 31317-309 | 2171789 | ELECTRICAL WORK MECHANICAL ROOMS - BUILDINGS #172, #442, #443 |
| 8 | 31318-309 | 2171790 | ELECTRICAL WORK MECHANICAL ROOMS - BUILDINGS #678, #444 |




VICINITY MAP

ABBREVIATIONS


| | |
|--------|------------------------------|
| DWG. | DRAWING |
| TYP. | TYPICAL |
| EA. | EACH |
| GPM | GALLONS PER MINUTE |
| PSIG | POUNDS PER SQUARE INCH GAUGE |
| HP. | HORSEPOWER |
| W/ | WITH |
| O.C. | ON CENTER |
| CLG. | CEILING |
| EXIST. | EXISTING |

SYMBOLS

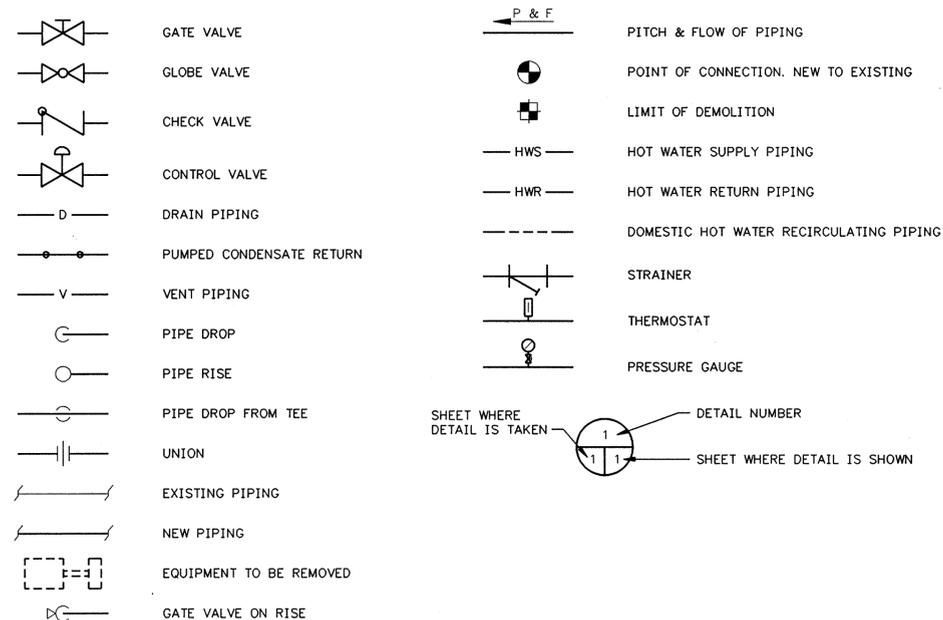


| | | | | | | | |
|--|----------|----------------------------|------|-----------------------------------|-------------|--------------------------------------|---------|
| AS BUILT | 11-15-96 | | | | | | |
| DESIGN | BR. HD. | DR. | DATE | SYMBOL | DESCRIPTION | DATE | BY WHOM |
| | | | | | | | |
| | | | | DATE: 7-14-95 SALES OFFICE TO: | | | |
| DEPARTMENT OF THE NAVY NAVAL FACILITIES ENGINEERING COMMAND NAVAL EDUCATION AND TRAINING CENTER NEWPORT, R.I. REPLACEMENT OF PUMPS AND PUMP MOTORS AT FIVE NETC BOQ BUILDINGS TITLE SHEET | | | | | | | |
| CODE I.D. NO. 80091 | | DRAWING SIZE: D | | SCALE: AS NOTED | | CONST. CONTRACT NO. N62472-95-C-2200 | |
| SPEC. NO. 95-C-2200 | | NAVFAC DRAWING NO. 2171783 | | N.E.T.C. DRAWING NO. 31311-309 | | SHEET 1 OF 8 | |




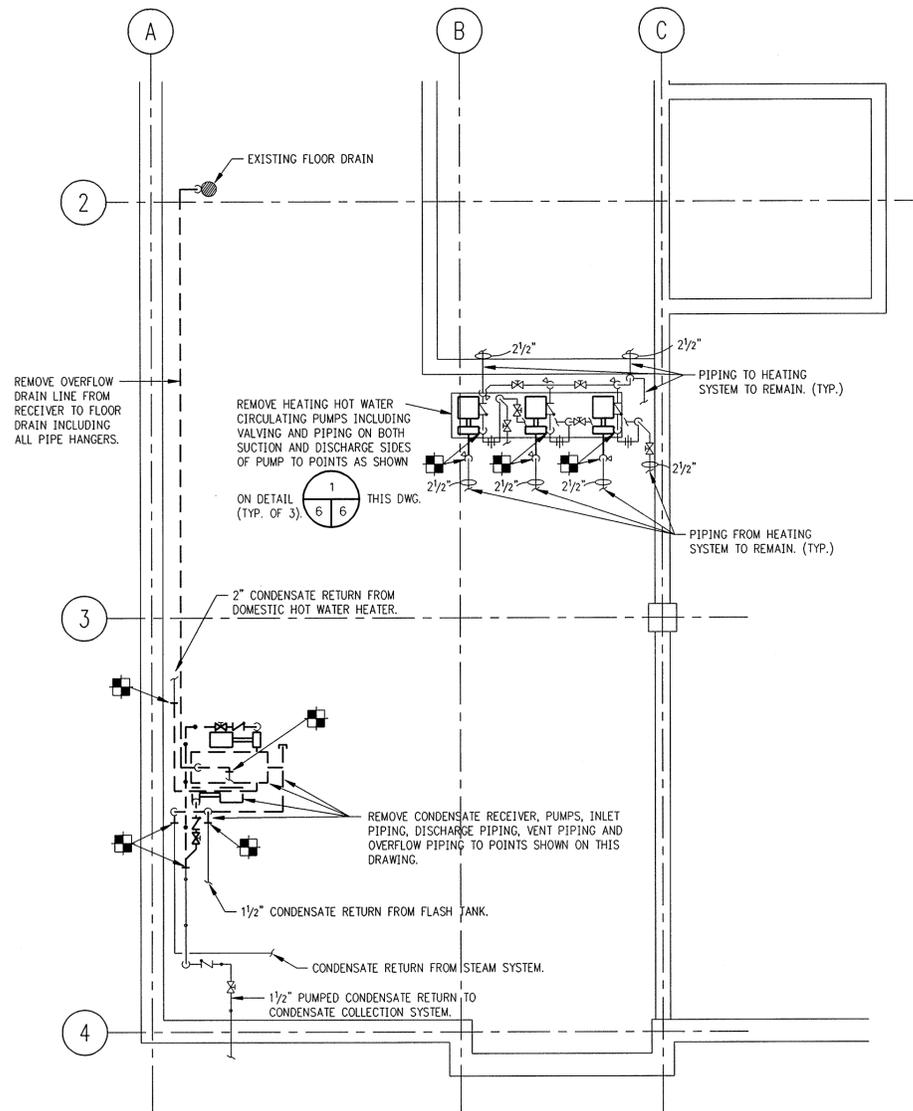

BUILDING #678 MECHANICAL ROOM PLAN - DEMOLITION
SCALE: 1/4"=1'-0"

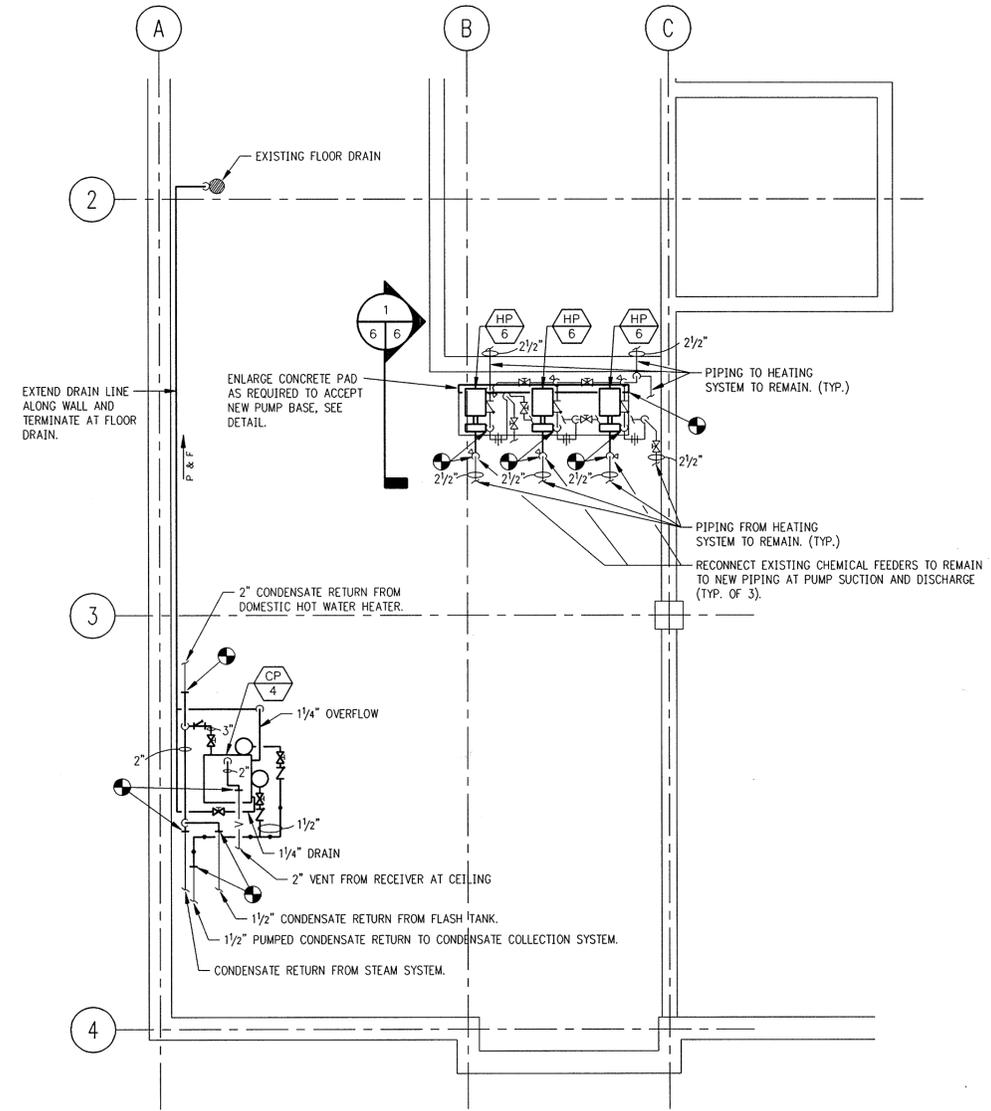


BUILDING #678 MECHANICAL ROOM PLAN - NEW WORK
SCALE: 1/4"=1'-0"

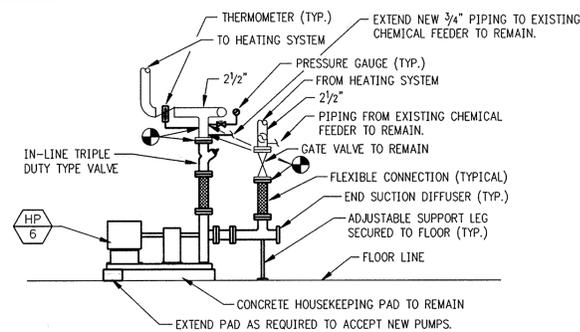

SECTION AT HEATING H.W. PUMPS-BLDG #678
SCALE: 1/2"=1'-0"

ALL DIMENSIONS AND EXISTING CONDITIONS SHALL BE CHECKED AND VERIFIED BY THE CONTRACTOR AT THE SITE.

5557M5

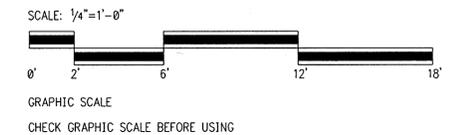

Q3G
QUAD THREE GROUP INC.
37 N. WASHINGTON STREET, WILKES-BARR, PA 18701

| | | |
|---|-------------------|------|
| DATE | BY | WHOM |
| 6-13-96 | MD | |
| REVISIONS | | |
| NO. | DESCRIPTION | DATE |
| 1 | AS BUILT 11-13-96 | |
| DSGN. DR. <i>J. J. Conroy, P.E.</i> BR. HD. <i>J. J. Conroy, P.E.</i> DIV. HD. <i>J. J. Conroy, P.E.</i> APPROVED <i>J. J. Conroy, P.E.</i> DATE <i>1-14-95</i> | | |
| DEPARTMENT OF THE NAVY NAVAL FACILITIES ENGINEERING COMMAND NAVAL EDUCATION AND TRAINING CENTER NEWPORT, R.I. REPLACEMENT OF PUMPS AND PUMP MOTORS AT FIVE NETC BOB BUILDINGS MECHANICAL ROOM PLAN - BUILDING #678 | | |
| CODE I.D. NO. | 80091 | |
| DRAWING SIZE: | D | |
| SCALE: | 1/4"=1'-0" | |
| CONST. CONTRACT NO. | N62472-95-C-2200 | |
| SPEC. NO. | 95-C-2200 | |
| NAVAC DRAWING NO. | 2171788 | |
| N.E.T.C. DRAWING NO. | 31316-309 | |
| SHEET | 6 | OF 8 |

