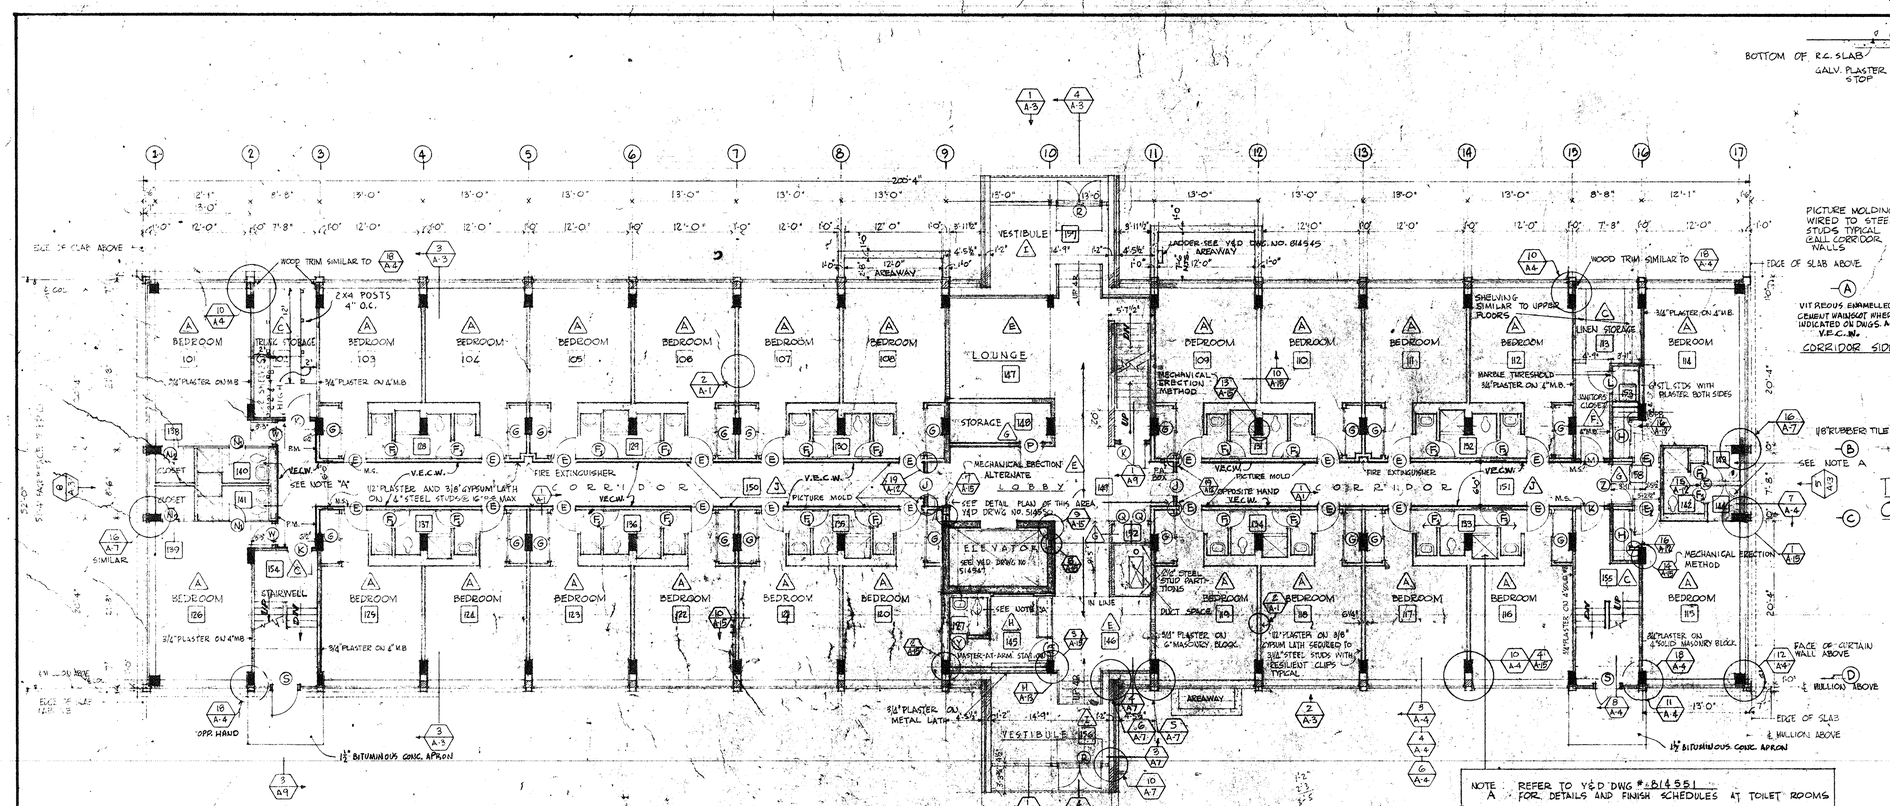

FIRST FLOOR PLAN

SCALE 1/8" = 1'-0"
FLOOR ELEVATION 20.00

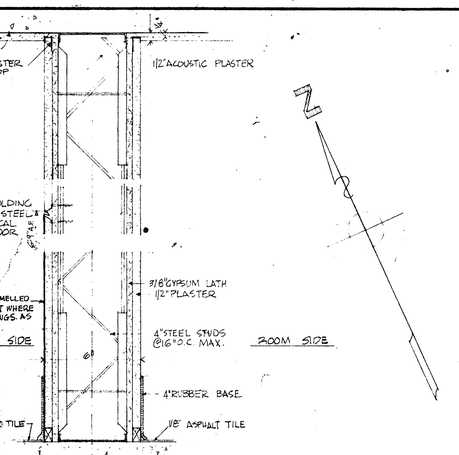

TYPICAL SECTION AT (1/A-1) CORRIDOR WALLS

SCALE 3"=1'-0"

NOTE A: REFER TO Y&D DWG #814551 FOR DETAILS AND FINISH SCHEDULES AT TOILET ROOMS

NOTE B: REFER TO Y&D DWG. #814539 FOR TYPICAL BEDROOM CLOSET & MISCELLANEOUS TYP. SHELVING DETAILS

NOTE C: REFER TO Y&D DWG# 814539 FOR DOOR SCHEDULE.

ROOM FINISH SCHEDULE

SYMBOL	FLOOR	BASE	WALL	CEILING FINISH	CEILING HEIGHT	REMARKS
A	ASPHALT TILE	4" RUBBER BASE	PLASTER - SEE REMARKS COLUMN	ACOUSTIC PL. ONLY IN RMS. 240, 246 & 248	8'-0"	COLUMNS AT CLOSETS ARE EXPOSED CONCRETE
B	ASPHALT TILE	4" RUBBER BASE	PLASTER - SEE REMARKS COLUMN	1/2" ACOUSTIC PLASTER	8'-0"	COLUMNS AT CURTAIN WALL AND WITHIN CLOSETS ARE EXPOSED CONCRETE.
C	CONCRETE	4" RUBBER BASE	EXPOSED CONCRETE MASONRY UNITS	CONCRETE	8'-0 1/2"	COLS AT CURTAIN WALL & FIRST FLOOR ARE PLASTERED
D	CONCRETE	NONE	CONCRETE & CONCRETE MASONRY UNITS	CONCRETE	8'-8 1/2"	
E	RUBBER TILE	4" RUBBER BASE	PLASTER, PLASTIC LAMINATE, GLAZED BRICK	ACOUSTIC PLASTER	8'-0"	REFER TO FLOOR PLAN SHEETS
F	CERAMIC TILE	COVE BASE	PLASTER	CONCRETE	8'-0 1/2"	MARBLE THRESHOLD @ DOOR F1
G	RUBBER TILE	4" RUBBER BASE	PLASTER EXCEPT WHERE INDICATED OTHERWISE	CERAMIC TILE TO 4'-0" ACOUSTIC PLAS. CONC. & STL. MT. 247 STEEL, BOX-TIES	8'-0" 8'-0" 7'-0"	COLS WITHIN CLOSETS ARE EXPOSED CONCRETE. PLAS. CORRIDOR WALLS
H	RUBBER TILE	4" RUBBER BASE	PLASTER, PLASTIC LAMINATE SEE PLAN	12" ACOUSTIC PLASTER	8'-0"	SEE FLOOR PLANS
I	RUBBER TILE	4" RUBBER BASE	GLAZED BRICK, PLASTER	1/2" ACOUSTIC PLASTER	10'-0"	SEE FLOOR PLANS
J	RUBBER TILE	4" RUBBER BASE	VIT. ENAMELLED CEMENT ON PLASTER - 6'-9" HIGH	1/2" ACOUSTIC PLASTER	8'-0"	SEE PLAN FOR V.E.C. LOCATION - SEE SECT (A/A-7)

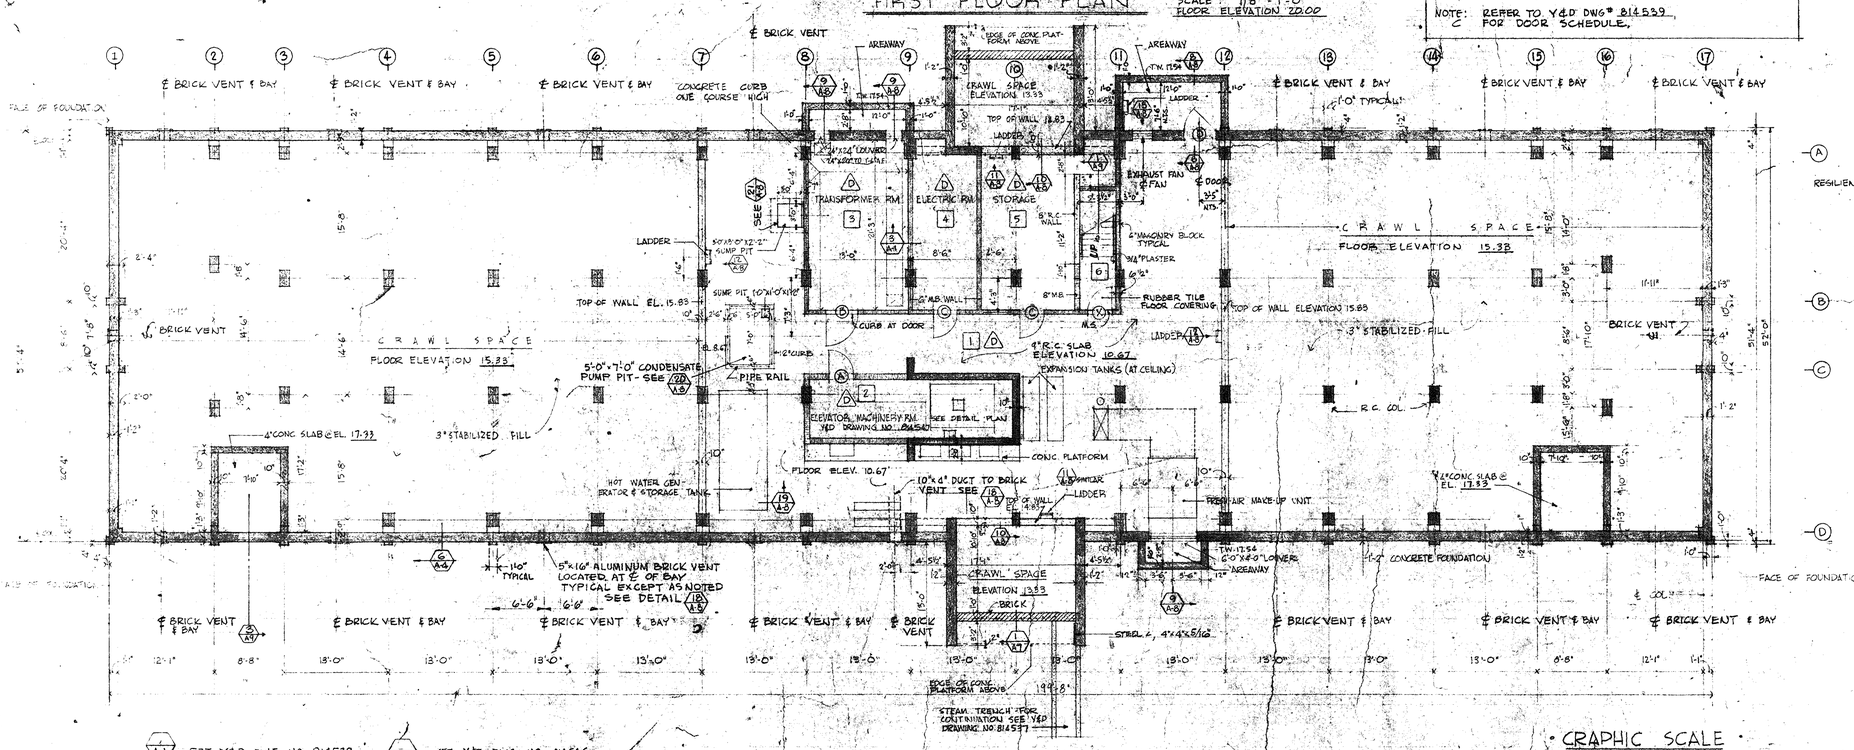

BASEMENT PLAN

SCALE 1/8" = 1'-0"
FLOOR ELEVATION 10.67

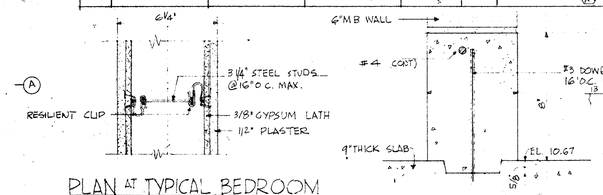

PLAN AT TYPICAL BEDROOM PARTITION (2/A-1)

SCALE 3"=1'-0"

CURB AT TRANSFORMER ROOM (3/A-1)

SCALE 3"=1'-0"

LEGEND AND ABBREVIATIONS

	CONCRETE	R.C.	REINFORCED CONCRETE
	CONCRETE MASONRY BLOCK	GALV.	GALVANIZED
	BRICK	CONT.	CONTINUOUS
	STEEL STUD PARTITION	V.E.C.W.	VITREOUS ENAMELED CEMENT WAINSCOT 6'-9" HIGH
COL.	COLUMN	NTS.	NOT TO SCALE
M.B.	MASONRY BLOCK		
℄	CENTER LINE		
H.P.	HORSE POWER		
Y.&D.	YARDS AND DOCKS		
PL.	PLASTER		
NO.	NUMBER		
A.F.	ABOVE FLOOR		
ST'L STD'S	STEEL STUDS		
DN	DOWN		
EL.	ELEVATION		
RM.	ROOM		
@	AT		
O.C.	ON CENTER		
MAX.	MAXIMUM		
DWG#	DRAWING NUMBER		
T.W.	TOP OF WALL		
P.M.	PICTURE MOLD		
M.S.	METAL FLOOR COVERING STOP		

RECORD DRAWING
DATE 19 NOV. '64
72 CHI

P.W.C. DWG. NO. 13480-141

SYMBOL	DESCRIPTION	DATE	APPROVAL
	REVISED TO "AS BUILT" CONDITIONS		LHL

REVISIONS

DPWO DRAWING NO. NBN-80 A-1

A & E

DRAWN BY O.B.R.
CHECKED BY S.A.G.
APP'D BY R.P.K.

DPWO 1ST ND
SAN. ENGR.
SAF'Y ENGR.
FIRE PROT. GLEASON
PROJ. ENGR. DAVIDSEN
DIRECTOR SEDDON

DEPARTMENT OF THE NAVY BUREAU OF YARDS & DOCKS
DISTRICT PUBLIC WORKS OFFICE 1ST ND BOSTON MASS.
CULL, ROBINSON AND GREEN
PROVIDENCE, RHODE ISLAND

U.S. NAVAL BASE, NEWPORT, R.I.

BACHELOR OFFICERS' QUARTERS

BASEMENT AND FIRST FLOOR PLANS

APPROVED
DATE

APPROVED FOR BUREAU OF YARDS & DOCKS
DPWO FOR CHIEF OF BUREAU
DATE 5/6/58

SCALE: AS NOTED
SHEET 3 OF 38
SPEC. 12819/57
NBY 12819
Y&D DRAWING NO. 814538

SUBMITTED:
DATE:

SATISFACTORY TO:
DATE

GRAPHIC SCALE
1/8" = 1'-0"
1/4" = 1'-0"