REVISIONS				
LTR	DESCRIPTION	PREP'D BY	DATE	APPROVED
	AS BUILT	D.B.	1-16-86	D.B.

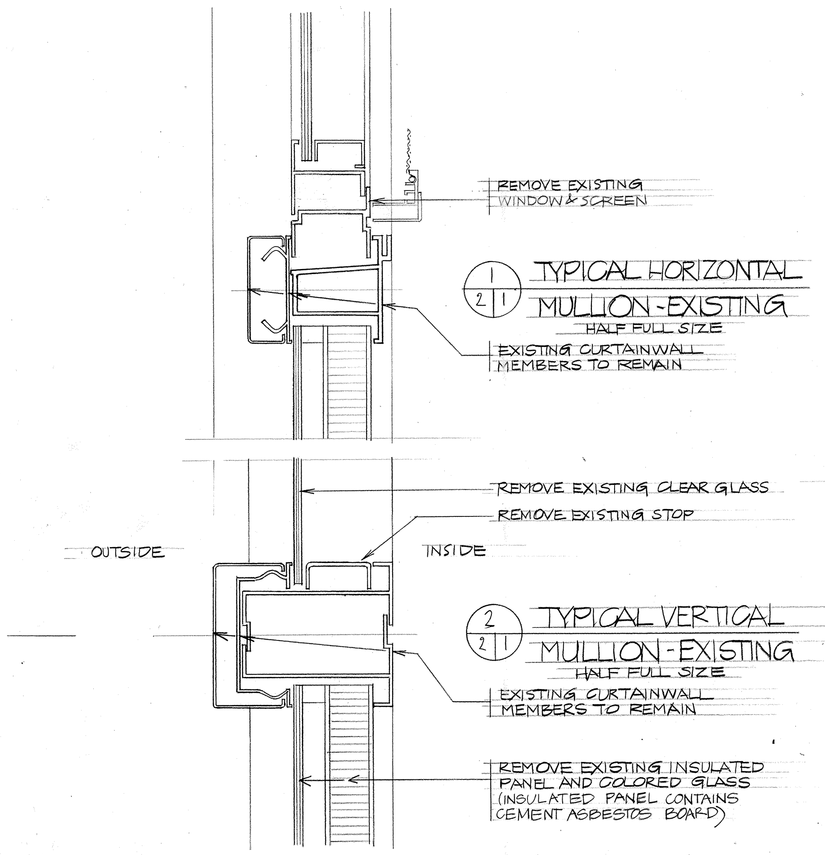

1/2 1 TYPICAL HORIZONTAL MULLION - EXISTING
HALF FULL SIZE

2/2 1 TYPICAL VERTICAL MULLION - EXISTING
HALF FULL SIZE

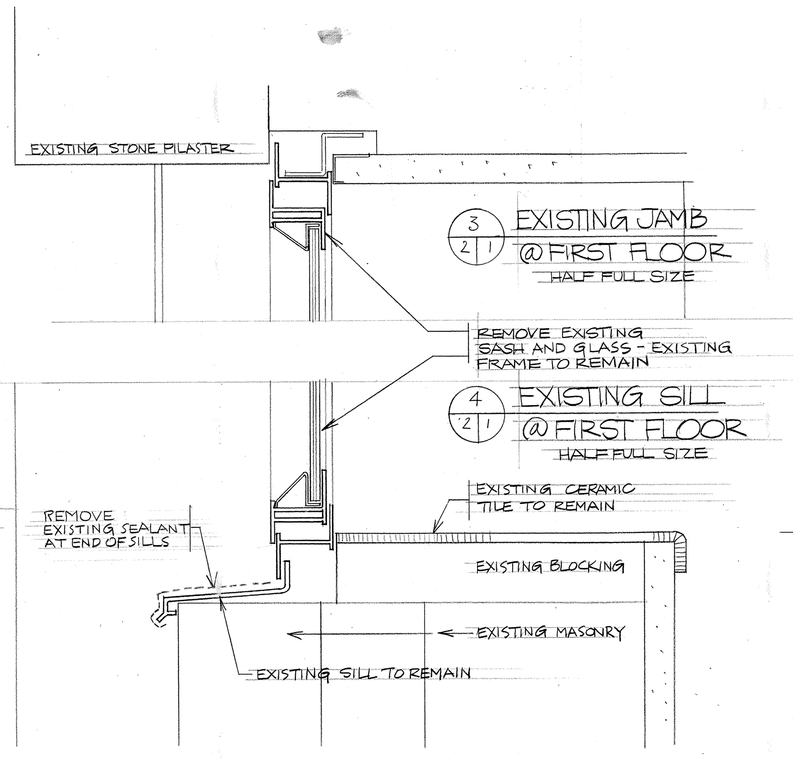

3/2 1 EXISTING JAMB @ FIRST FLOOR
HALF FULL SIZE

4/2 1 EXISTING SILL @ FIRST FLOOR
HALF FULL SIZE

TYPICAL EXISTING WINDOWS

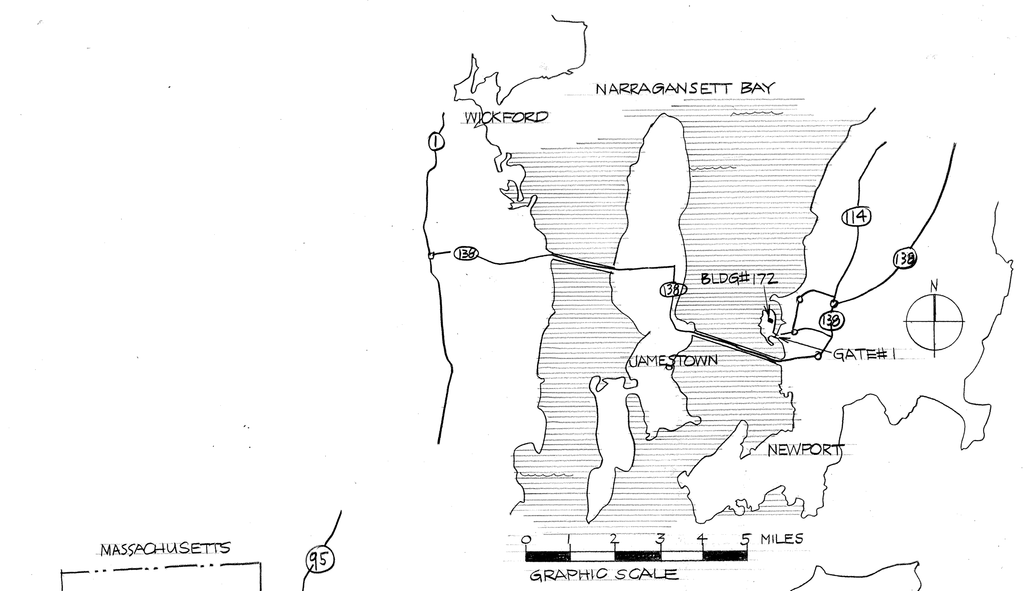

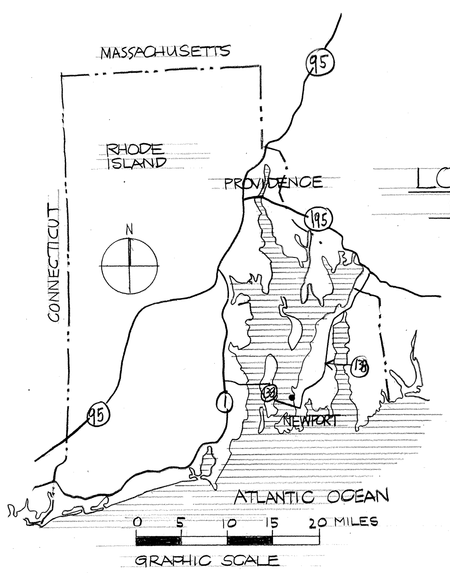

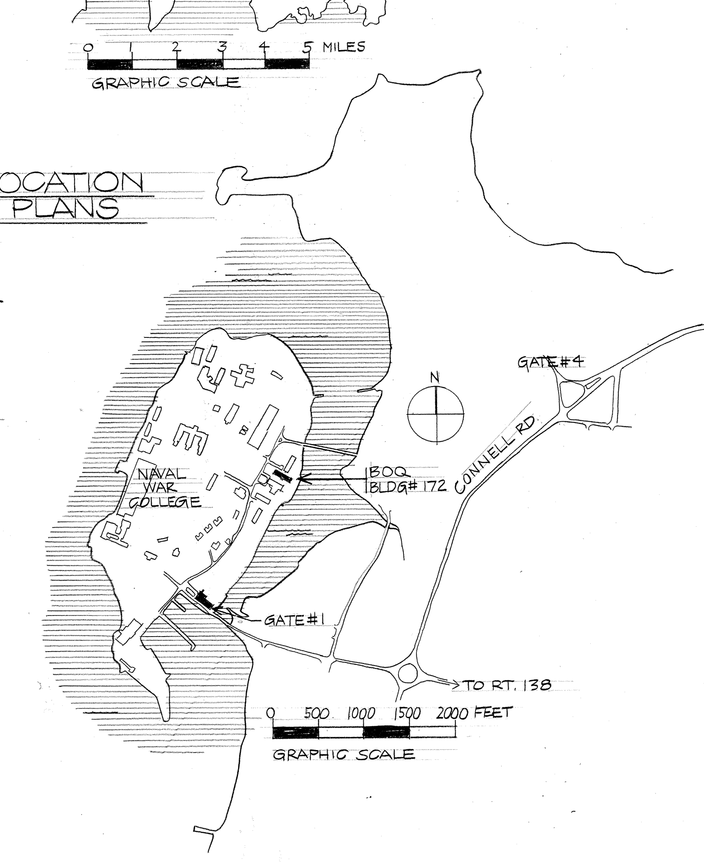

0 1" 2" 3" 4" 5" 6" 7"
HALF FULL SIZE

CHECK GRAPHIC SCALES BEFORE USING

RAFFAELE LAMBORGHINI No. 229 REGISTERED ARCHITECT

LAMBORGHINI & PIPKA
PROVIDENCE, RHODE ISLAND
ARCHITECTS

DSGN DN CHK
SUBMITTED BY 17 FEB 1983 DATE
FIRM MEMBER
NORDIV HD
DM HD
FPE DIR TUTEN
APPROVED DATE
OFFICER IN CHARGE
APPROVED DATE
NORDIV FOR COMMANDER NAVFAC

SATISFACTORY TO: DATE
COMNETC NEWPORT 1 MAR 83
LTR. H. BELSON

DEPARTMENT OF THE NAVY NAVAL FACILITIES ENGINEERING COMMAND
NORTHERN DIVISION
NAVAL BASE PHILADELPHIA, PA.

NAVAL EDUCATION AND TRAINING CENTER
NEWPORT, RI
REPLACE WINDOWS BOQ# 172
LOCATION PLAN

SIZE	CODE IDENT. NO.	NAVFAC DRAWING NO.
F	80091	2065303

CONSTR. CONTR. NO. N62472-81-C-0238
SCALE AS NOTED | SPEC. 04-81-0238 | SHEET 1 OF 3 | A1

NETC DWG. NO. 25679-253

REVISIONS				
LTR	DESCRIPTION	PREP'D BY	DATE	APPROVED
	AS BUILT	D.B.	4-6-84	D.B.

AT THIS WINDOW PROVIDE 1" THICK INSULATED PANEL INSTEAD OF GLASS, AND RE-INSTALL EXISTING DRYER VENT.

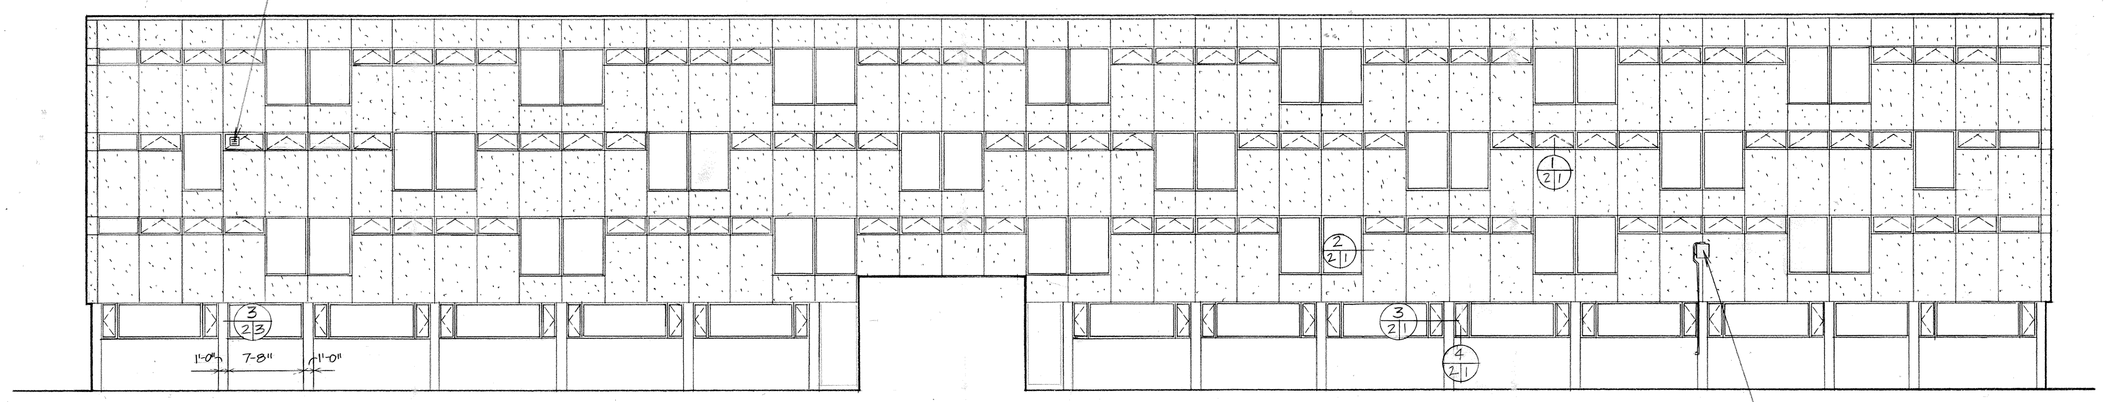

REMOVE EXISTING LIGHTING FIXTURE AND CONDUIT. RE-INSTALL AFTER WINDOWS ARE REPLACED

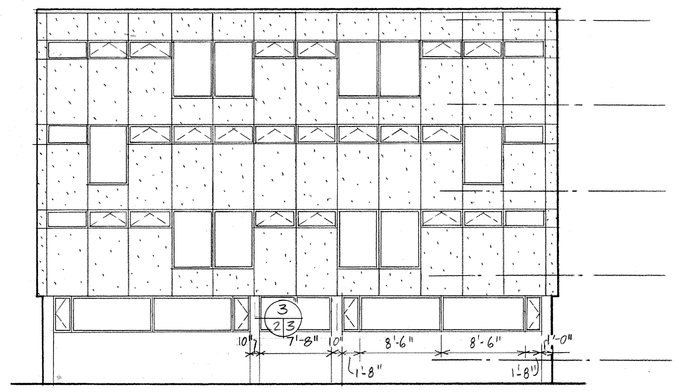

NORTH ELEVATION

1/8" = 1'-0"

CURTAIN WALL MULLIONS 46 BAYS @ 4'-4" O.C. = 199'-4"

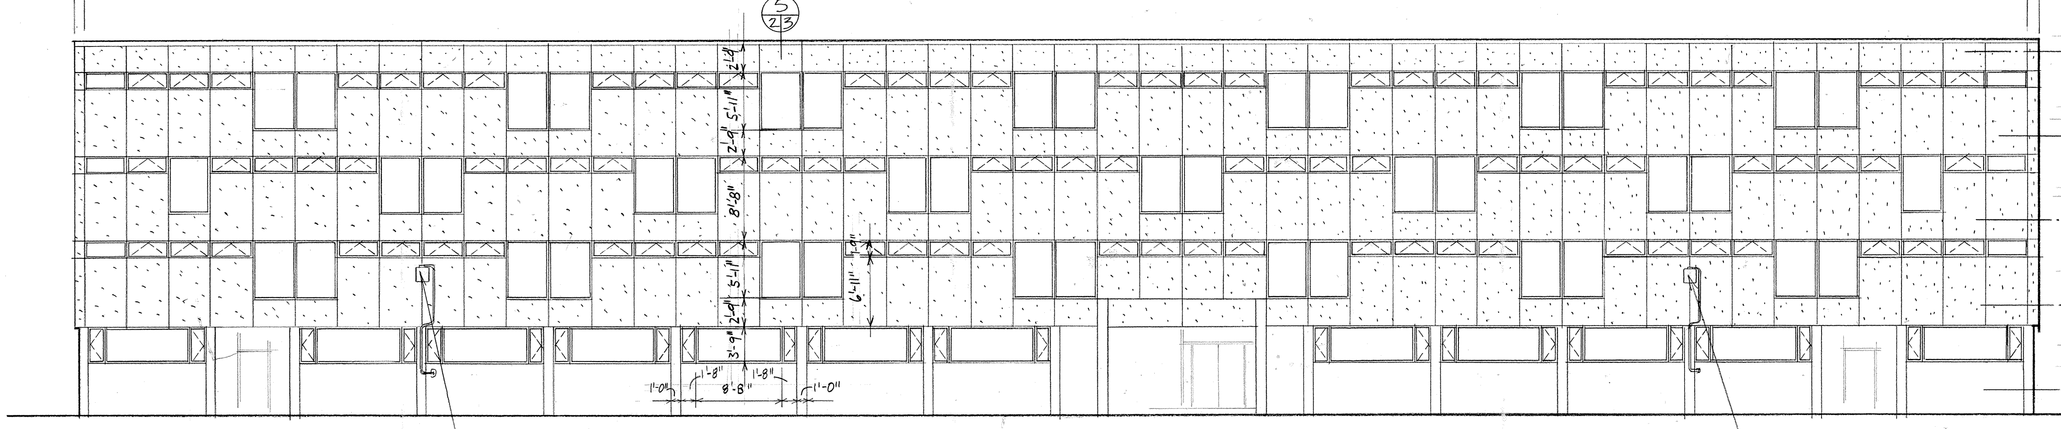

REMOVE EXISTING LIGHTING FIXTURE AND CONDUIT. RE-INSTALL AFTER WINDOWS ARE REPLACED

REMOVE EXISTING LIGHTING FIXTURE AND CONDUIT. RE-INSTALL AFTER WINDOWS ARE REPLACED

WEST ELEVATION

1/8" = 1'-0"

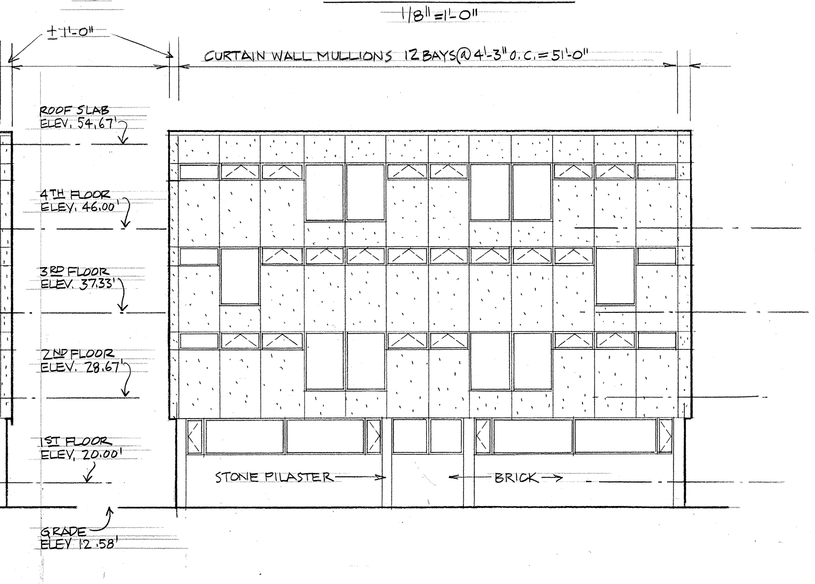

SOUTH ELEVATION

1/8" = 1'-0"

SYMBOL	WORK REQUIRED	
MULLIONS →	REMOVE EXISTING GLASS-FACED INSULATING PANEL. PROVIDE NEW INSULATED PANEL	UPPER LEVELS
	REMOVE EXISTING OUT-PROJECTING WINDOW AND SCREEN. PROVIDE NEW OUT-PROJECTING WINDOW WITH INSULATING GLASS AND SCREEN	UPPER LEVELS
	REMOVE EXISTING FIXED GLASS LIGHT AND STOP. PROVIDE NEW INSULATING FIXED GLASS AND STOP	UPPER LEVELS
	REMOVE EXISTING FIXED WINDOW PROVIDE NEW FIXED WINDOW WITH INSULATING GLASS	UPPER LEVELS
	REMOVE EXISTING CASEMENT SASH AND SCREEN. PROVIDE NEW CASEMENT WINDOW WITH INSULATING GLASS AND SCREEN	FIRST FLOOR
	REMOVE EXISTING GLASS. PROVIDE NEW FIXED WINDOW WITH INSULATING GLASS	FIRST FLOOR

SCHEMATIC KEY TO ELEVATIONS . NO SCALE

EAST ELEVATION

1/8" = 1'-0"

0 5 10 15 20 25 FEET

1/8" = 1'-0"

CHECK GRAPHIC SCALES BEFORE USING

SATISFACTORY TO: DATE

LAMBORGHINI & PIPKA
PROVIDENCE, RHODE ISLAND
ARCHITECTS

DSGN DN CHK
SUBMITTED BY 17 FEB 1983 DATE
FIRM MEMBER
NORDIV HD.
DM HD.
FPE DIR.
APPROVED DATE
OFFICER IN CHARGE
APPROVED DATE
NORDIV FOR COMMANDER NAVFAC

DEPARTMENT OF THE NAVY NAVAL FACILITIES ENGINEERING COMMAND
NORTHERN DIVISION
NAVAL BASE PHILADELPHIA, PA.

NAVAL EDUCATION AND TRAINING CENTER
NEWPORT, RI
REPLACE WINDOWS BOQ#172
ELEVATIONS

SIZE	CODE IDENT. NO.	NAVFAC DRAWING NO.
F	80091	2065304

CONSTR. CONTR. NO. N62472-81-C-0238
SCALE 1/8"=1'-0" SPEC. 04-81-0238 SHEET 2 OF 3 A2

NETC DWG. NO. 25680-253

REVISIONS				
LTR	DESCRIPTION	PREP'D BY	DATE	APPROVED
A	REVISED AS BUILT	D.B	1-16-24	D.B

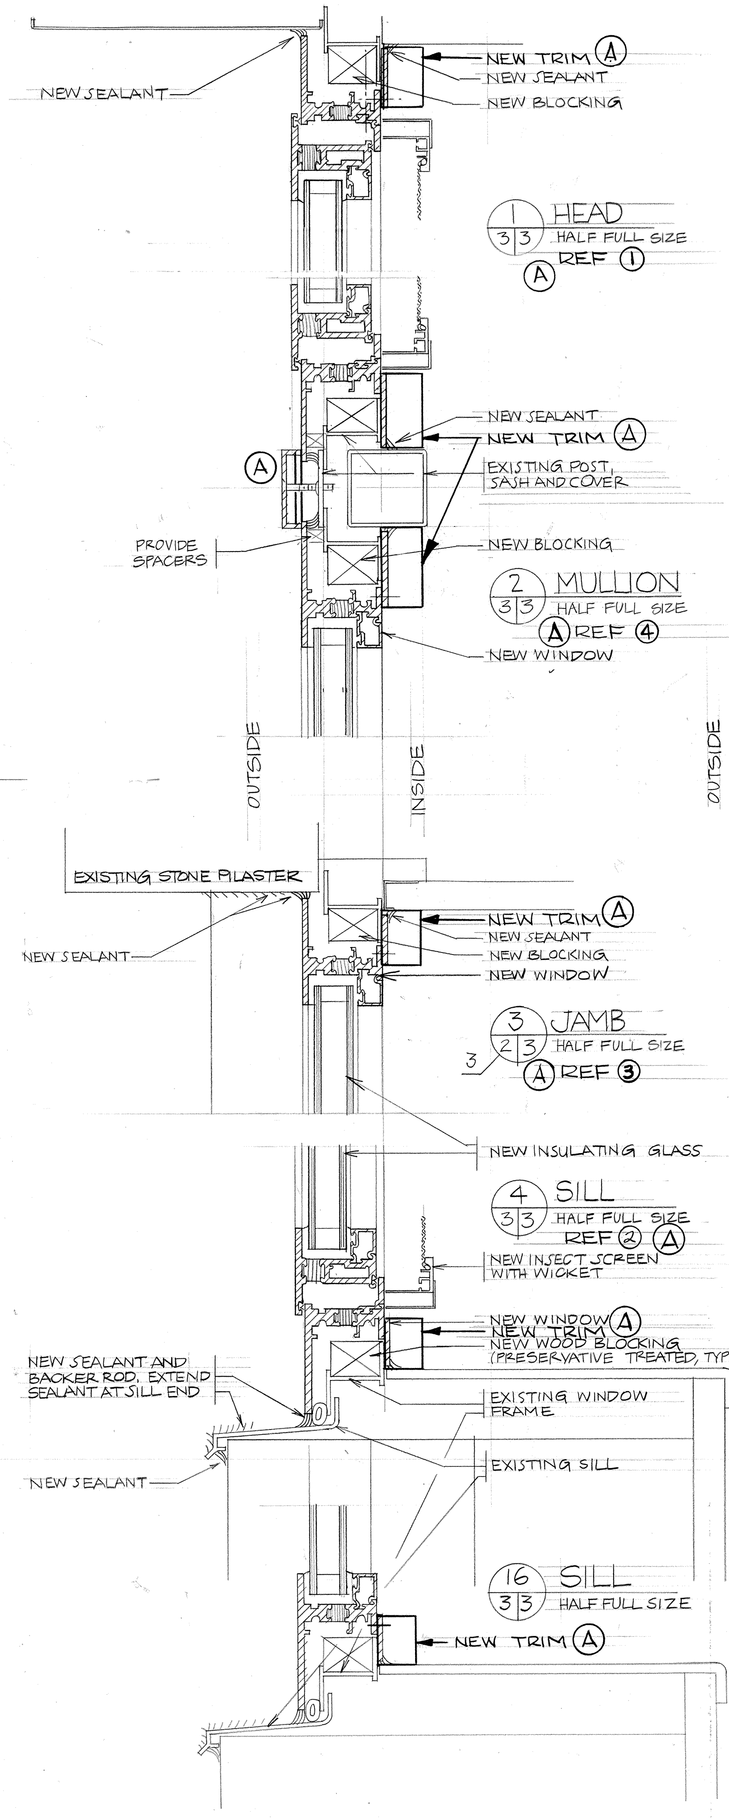

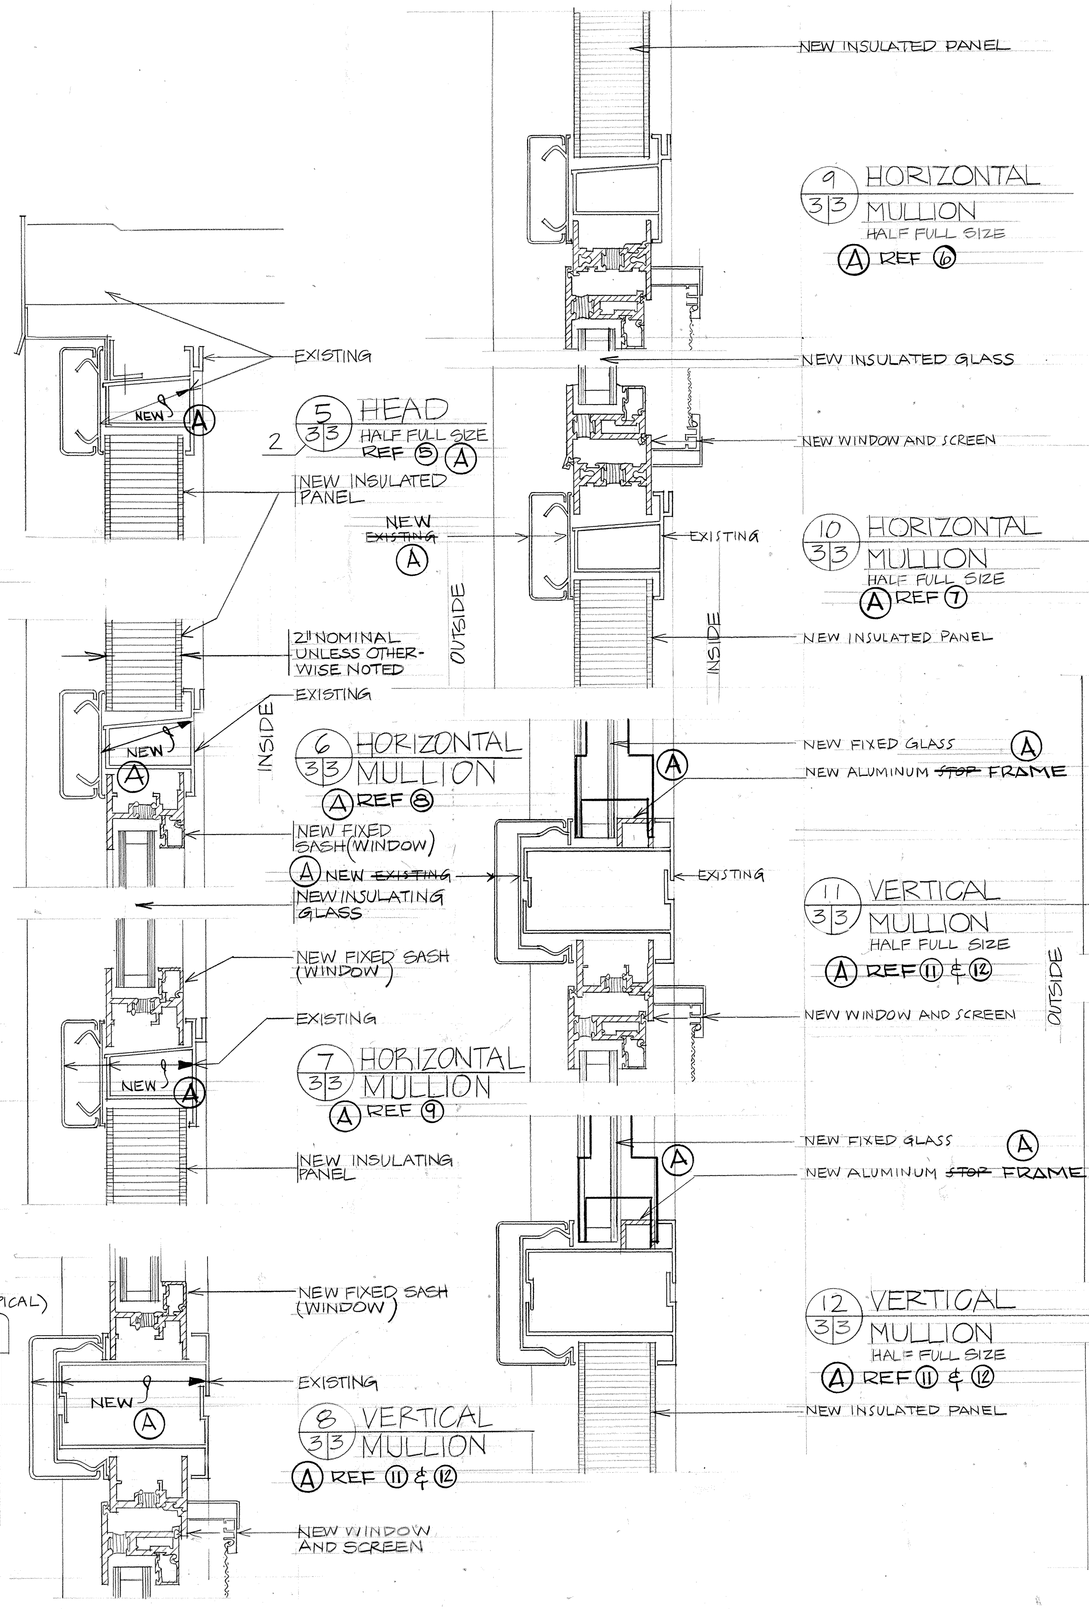

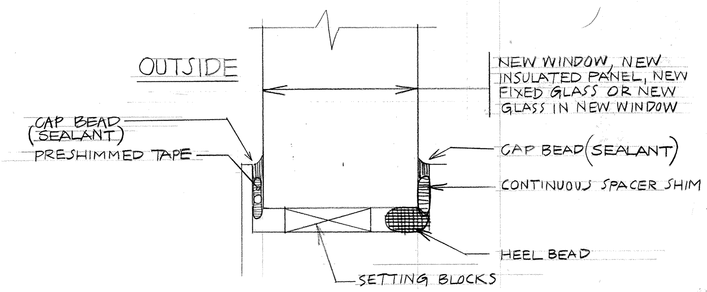

TYPICAL GLAZING METHOD - NO SCALE

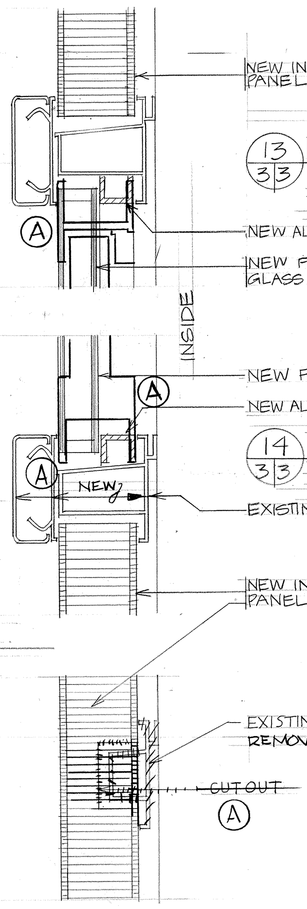

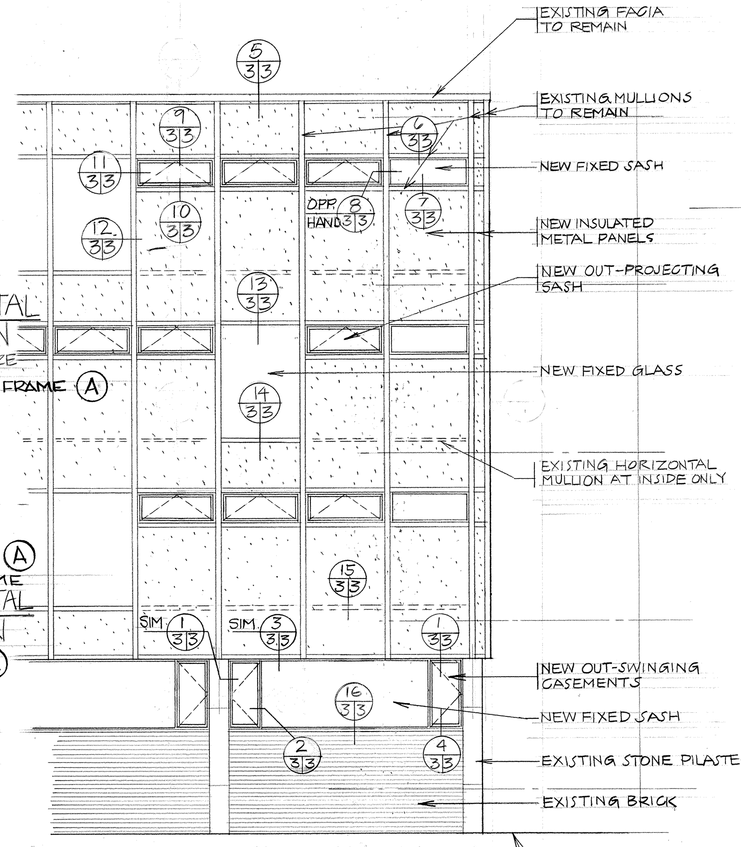

TYPICAL ELEVATION (PARTIAL)
1/4" = 1'-0"

0 1 2 3 4 8 12 FEET
1/4" = 1'-0"

0 1 2 4 8 INCHES
HALF FULL SIZE
CHECK GRAPHIC SCALES BEFORE USING

SATISFACTORY TO: DATE

LAMBORGHINI & PIPKA
PROVIDENCE, RHODE ISLAND
ARCHITECTS

DSGN DN CHK
SUBMITTED BY 17 FEB 1983 DATE
FIRM MEMBER
NORDIV HD
DM HD
FPE DIR
APPROVED DATE
OFFICER IN CHARGE
APPROVED DATE
NORDIV FOR COMMANDER NAVFAC

DEPARTMENT OF THE NAVY NAVAL FACILITIES ENGINEERING COMMAND
NORTHERN DIVISION
NAVAL BASE PHILADELPHIA, PA.

NAVAL EDUCATION AND TRAINING CENTER
NEWPORT, RI
REPLACE WINDOWS BOQ # 172
DETAILS

SIZE	CODE IDENT. NO.	NAVFAC DRAWING NO.
F	80091	2065305

CONSTR. CONTR. NO. N62472-81-C-0238
SCALE NOTED
SPEC. NO. 81-0238 SHEET 3 OF 3 A3

NETC DWG. NO. 25681-253