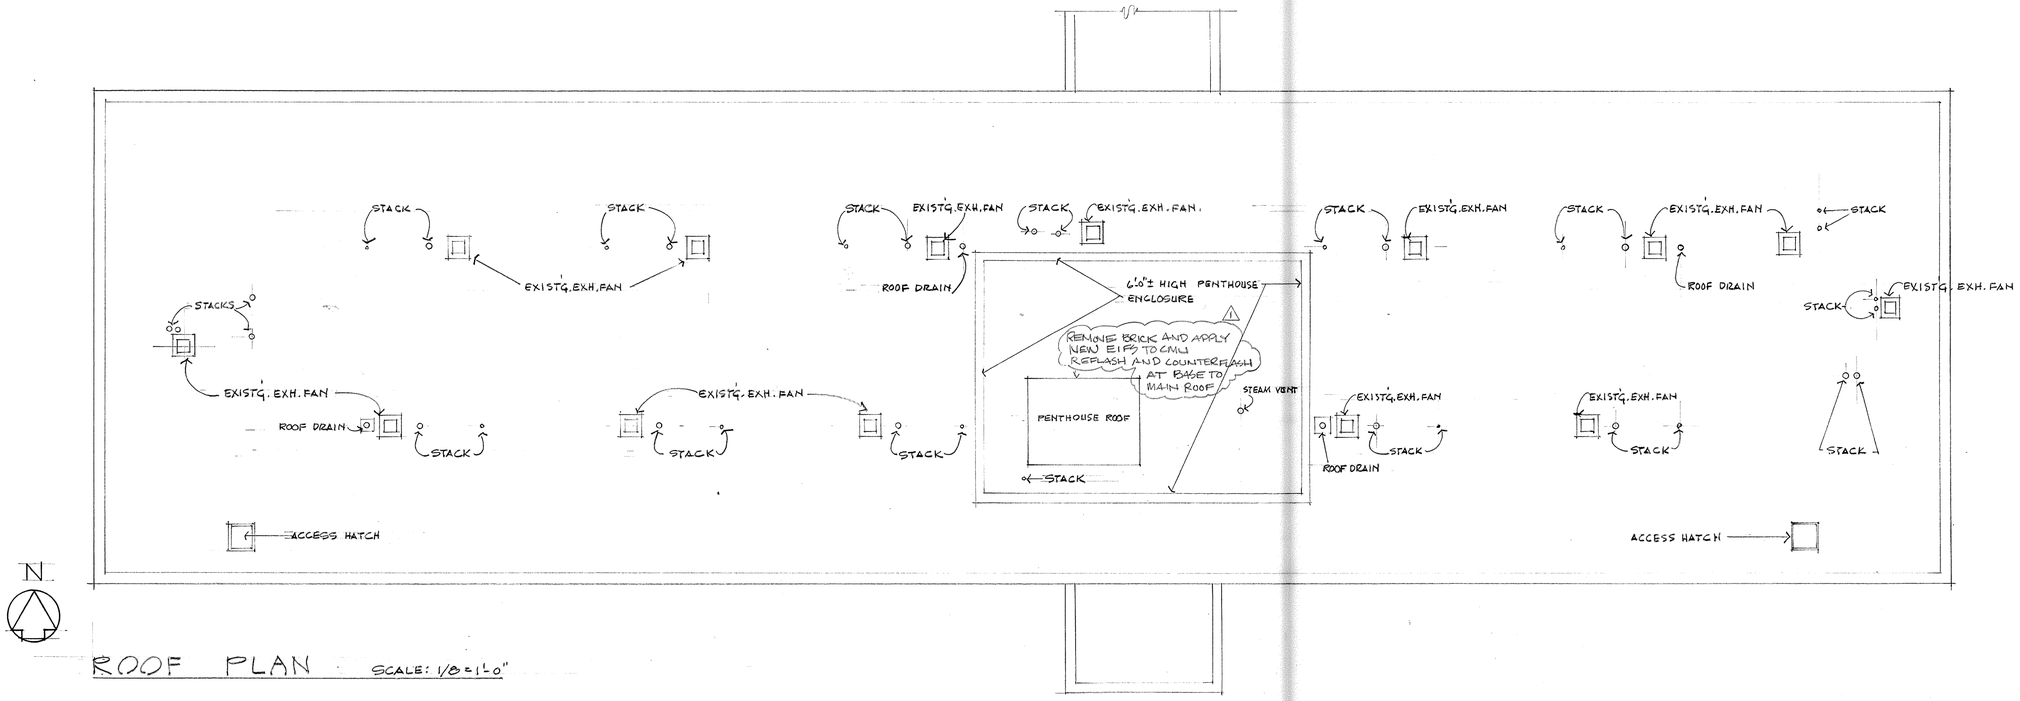

ROOF PLAN SCALE: 1/8"=1'-0"

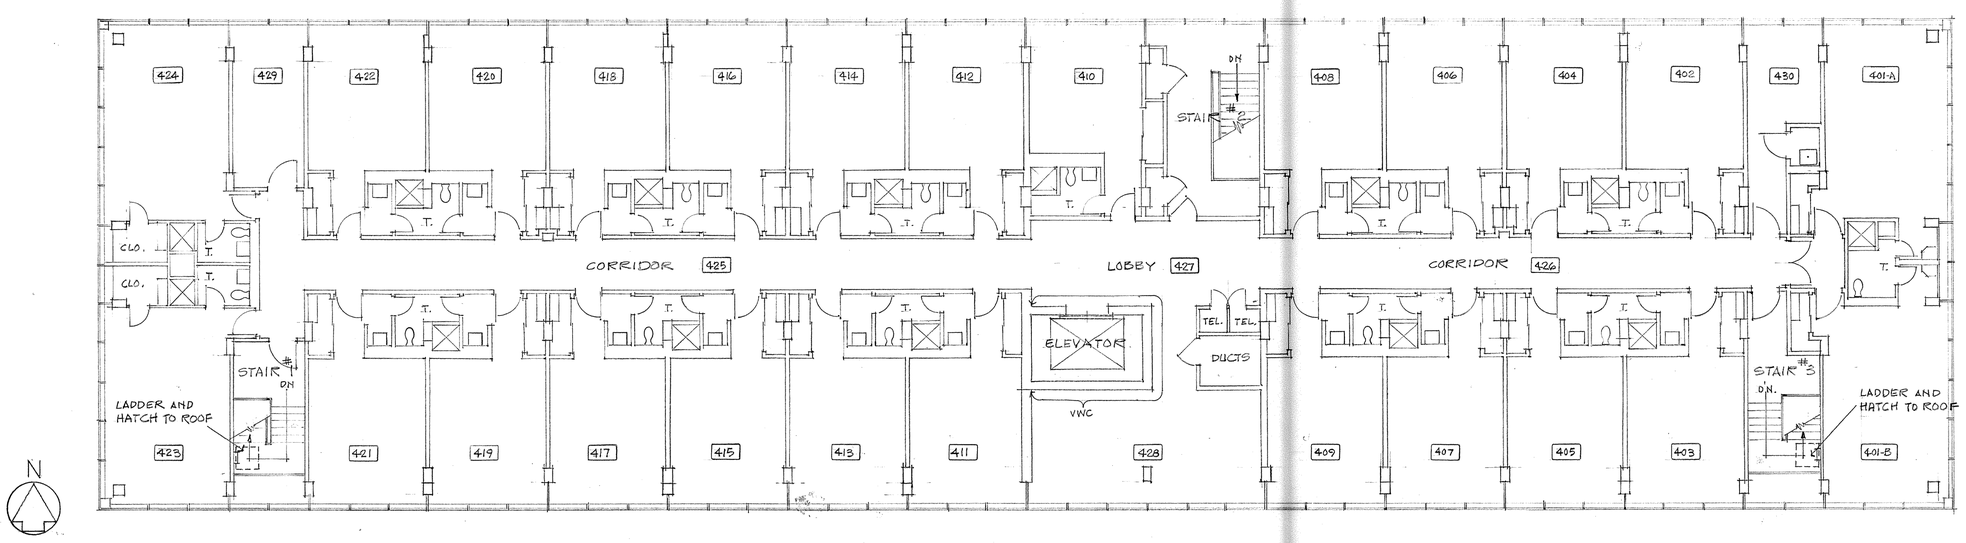

FOURTH FLOOR SCALE: 1/8"=1'-0"

NOTE!
FOR TYPICAL SECTIONS THRU EXISTING BUILDING, SEE "1ST FLOOR PLAN-EXISTING" NAVFAC DRAWING No. 2160324

EXISTING PLANS/SECTIONS ARE FOR INFORMATION ONLY.

1/8"=1'-0" 10 5 0 10 20

GRAPHIC SCALE

I. T. ALMY ASSOCIATES
958 REGAN ROAD
SOMERSET, MA 02726

SYMBOL	DESCRIPTION	DATE	APP'VD
1	AS BUILT 1-12-98	5-28-98	MD

REVISIONS

DSGN.
DR.
BR. HD. [signature]
DIV. HD. 7/15/93
APPROVED SAT TO [signature] DATE 7-16-93

APPROVED SATISFACTORY TO [signature] DATE 7/19/93

DEPARTMENT OF THE NAVY
NAVAL EDUCATION AND TRAINING CENTER
NAVAL FACILITIES ENGINEERING COMMAND
NEWPORT, R.I.

ALTERATIONS TO BUILDING #172, C.H.I.
4TH FLOOR & ROOF PLANS-EXISTING

CODE ID. NO. 80091
DRAWING SIZE D
SCALE: AS NOTED
CONST. CONTRACT NO. N62472-92-C-1671
SPEC. 04-92-1671
NAVFAC DRAWING NO. 2160326
N.E.T.C. DRAWING NO. 30061-297
SHEET 5 OF 28