REVISIONS				
LTR.	DESCRIPTION	PREP'D BY	DATE	APPROVED
1	EXISTING BRICK NOT REMOVED. EXISTING THRU WALL FLASHING REMAINED (EXCEPT FOR 5 BAYS ON EAST ELEVATION. SEE B/2)	ASAB	3/1/84	

AS BUILT 3/1/84

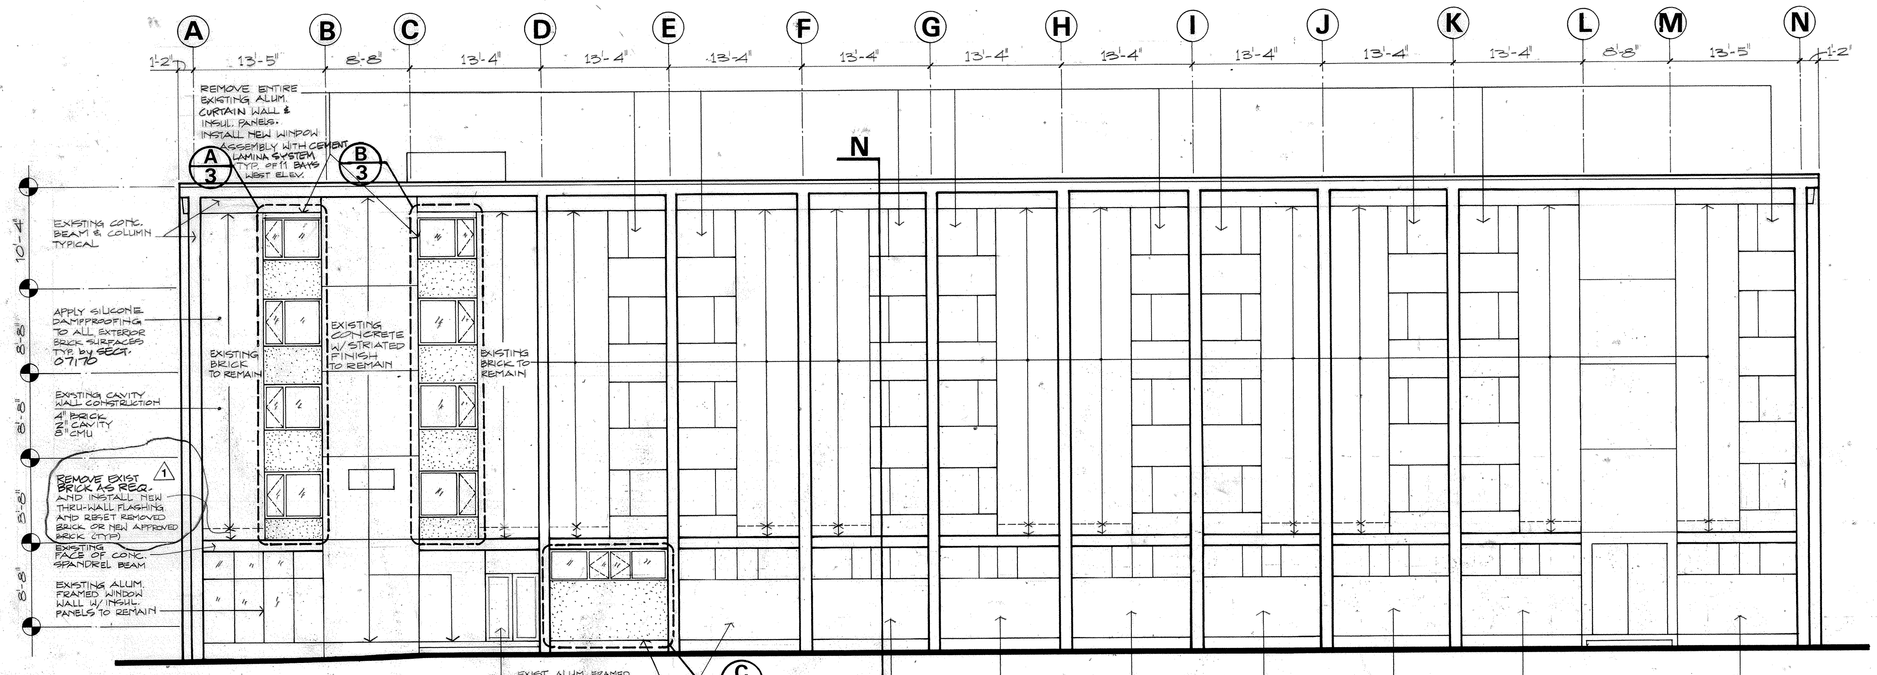

A/2 **WEST ELEVATION**
1/8" = 1'-0"

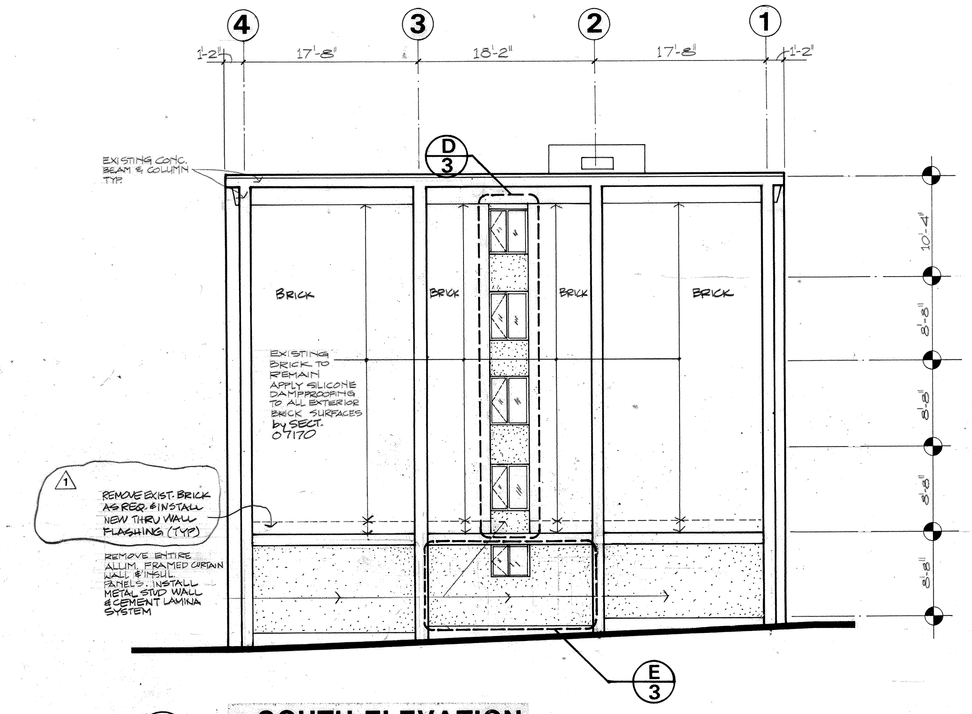

C/2 **SOUTH ELEVATION**
1/8" = 1'-0"

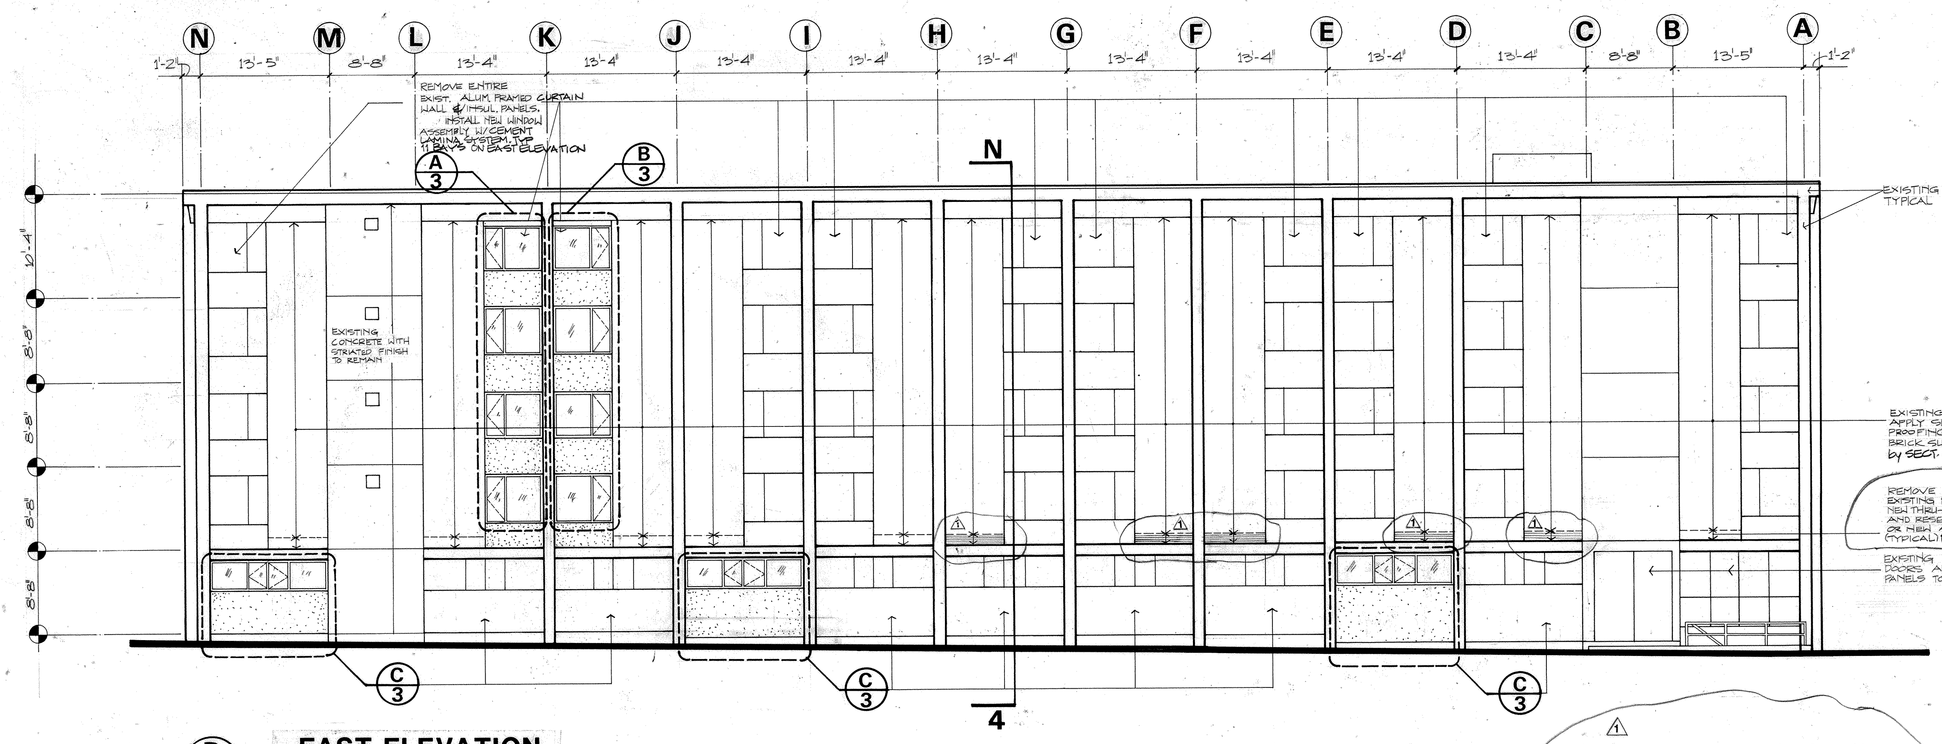

B/2 **EAST ELEVATION**
1/8" = 1'-0"

REMOVED & REPLACED EVE SECTIONS ONLY OF BRICK WORK ON EAST ELEVATION TO EXPOSE & INSPECT FLASHING. IT WAS AGREED BY MR. GALLIHER FROM ARCHITECTURAL FIRM OF GALLIHER SCHOENHARDT & BAIER, MR. LOU PAYAN (PROJECT MANAGER) & MR. ROGER PARADIS (FIELD INSPECTOR) THAT THE FLASHING WAS NOT THE CAUSE OF VARIOUS BUILDING LEAKS. REMOVAL OF BRICK WORK & REPLACING WITH NEW BRICK & FLASHING WAS ELIMINATED FROM CONTRACT

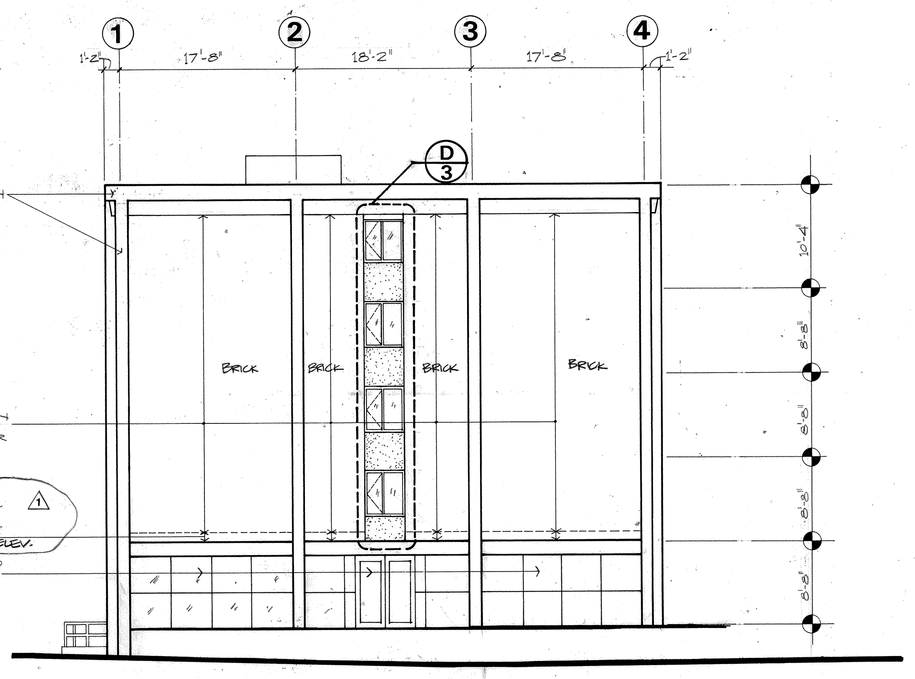

D/2 **NORTH ELEVATION**
1/8" = 1'-0"

ROGER E. GALLIHER No. 526 REGISTERED ARCHITECT

SATISFACTORY TO: W.H. Parmon
DATE: 8-2-82

NETC DWG NO. 22932-236

GALLIHER SCHOENHARDT & BAIER - ARCHITECTS
SIMSBURY CONNECTICUT
DWN SCG DATE 30 July 82 CHK NO. 82058
PARTNER R.E. Galliher

PROJ MGR 30 July 1982
ENG DIR 8/2/82
APPROVED W.H. Parmon CAPT CEC USN 8-2-82
OFFICER IN CHARGE DATE

DEPARTMENT OF THE NAVY — NAVAL FACILITIES ENGINEERING COMMAND
NAVAL EDUCATION AND TRAINING CENTER
NEWPORT, RHODE ISLAND

EXTERIOR WALL IMPROVEMENTS
BUILDING NO. 678
NAVAL COMPLEX, NEWPORT RHODE ISLAND

BUILDING ELEVATIONS

SIZE: F | CODE IDENT NO.: 80091 | NAVFAC DRAWING NO.: 2060432
CONSTR. CONTR. NO.: N62472-82-C-1756
SCALE: 1/8" = 1'-0" | SPEC: 04-82-1756 | SHEET 2 OF 4