REVISIONS				
LTR.	DESCRIPTION	PREP'D BY	DATE	APPROVED
1	STUD CHANGED FROM 3 5/8" to 2 1/2"	GSGB	3/1/84	
2	REVISED WOOD TRIM	GSGB	3/1/84	

AS BUILT 3/1/84

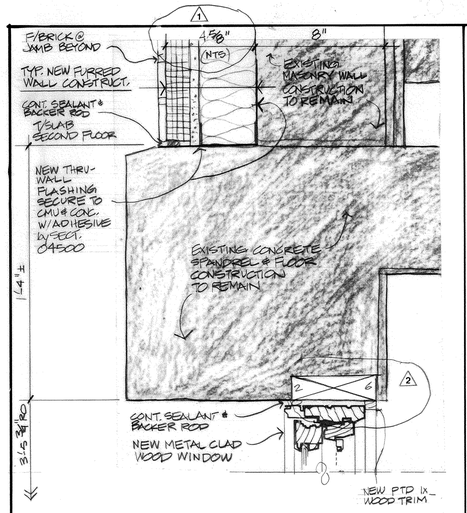

A FIRST FLOOR HEAD
SCALE: 3"=1'-0"

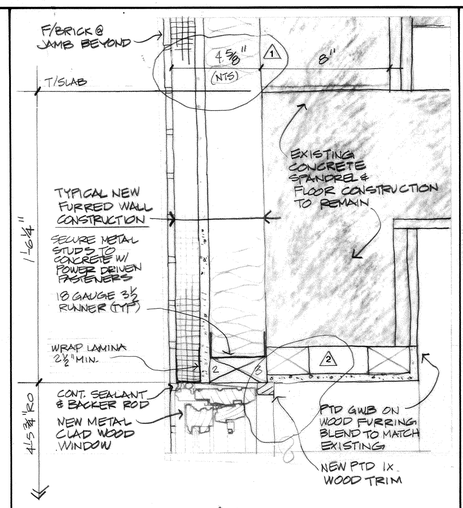

B 2-3-4 FLOOR HEAD
SCALE: 3"=1'-0"

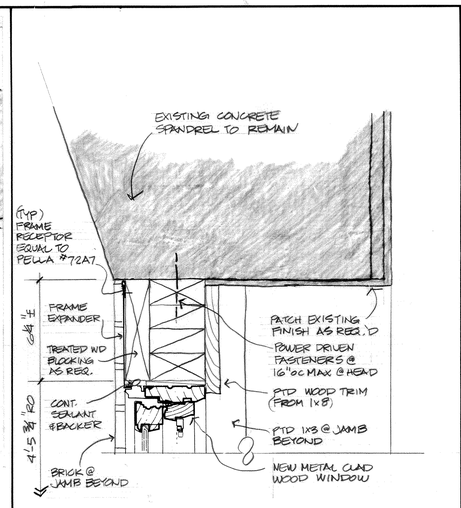

C FIFTH FLOOR HEAD
SCALE: 3"=1'-0"

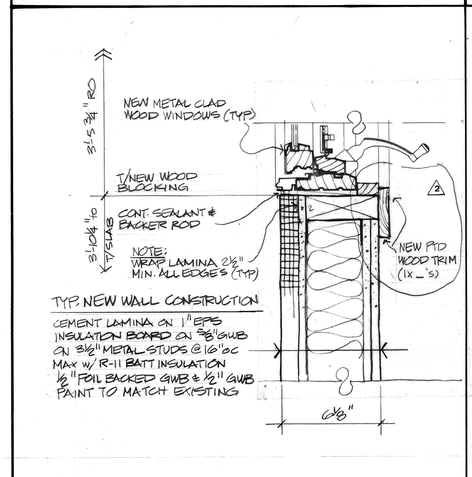

D FIRST FLOOR SILL
SCALE: 3"=1'-0"

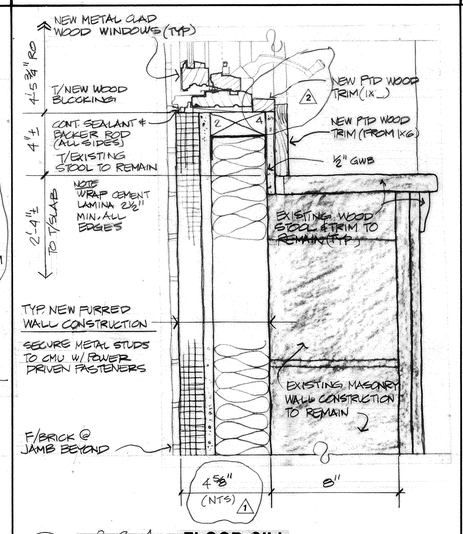

E 2-3-4 FLOOR SILL
SCALE: 3"=1'-0"

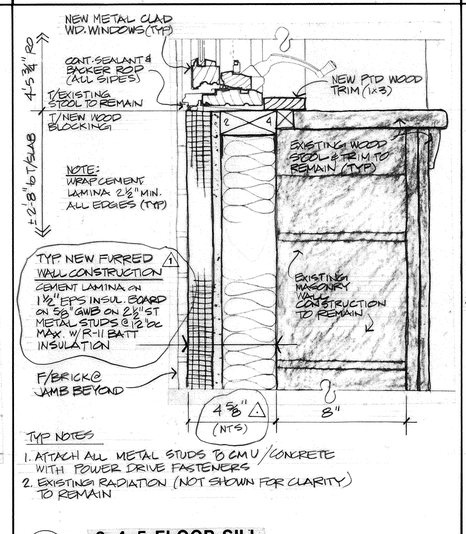

TYP NOTES
1. ATTACH ALL METAL STUDS TO CMU/CONCRETE WITH POWER DRIVE FASTENERS
2. EXISTING RADIATION (NOT SHOWN FOR CLARITY) TO REMAIN

F 3-4-5 FLOOR SILL
SCALE: 3"=1'-0"

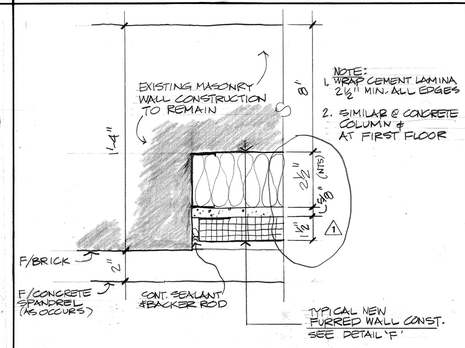

M CEMENT LAMINA JAMB
SCALE: 3"=1'-0"

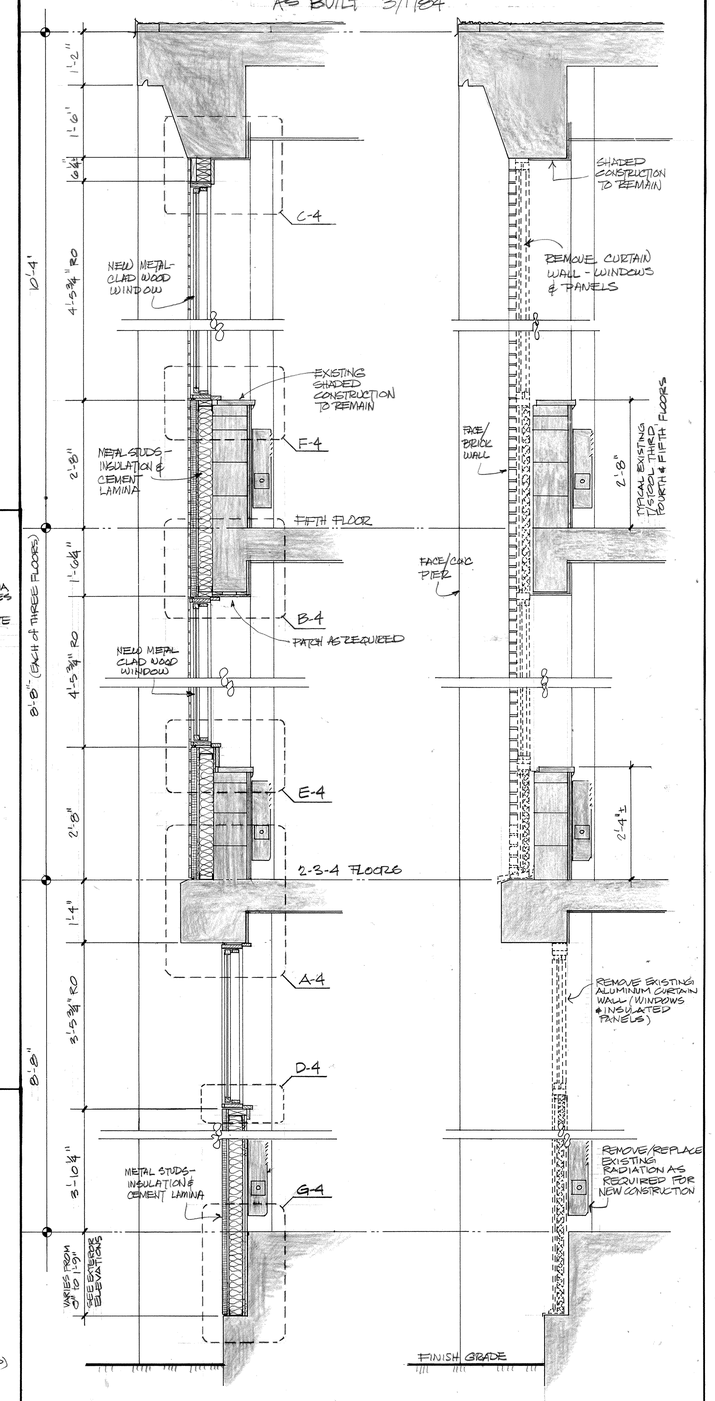

N NEW WALL SECTION
SCALE: 3/4"=1'-0"

P EXISTING WALL SECTION
SCALE: 3/4"=1'-0"

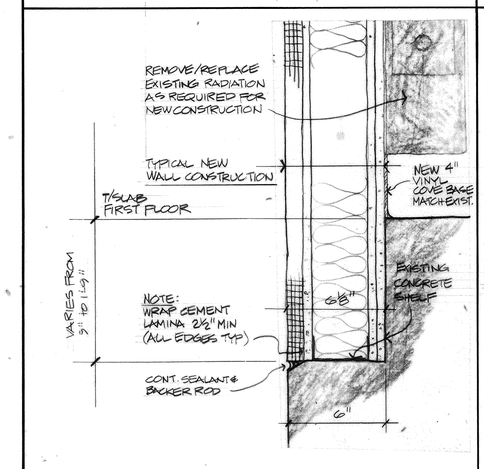

G FIRST FLOOR BASE
SCALE: 3"=1'-0"

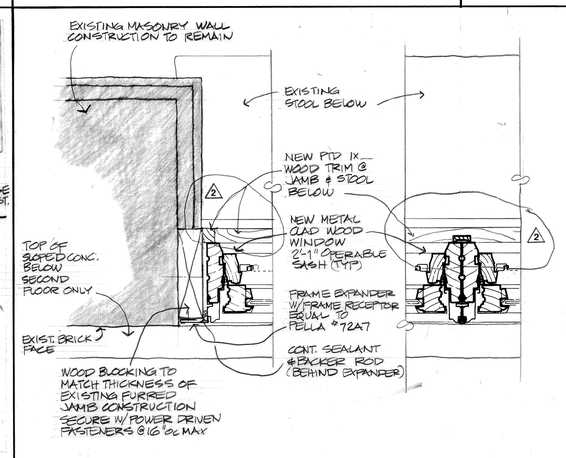

H TYPICAL BRICK JAMB
SCALE: 3"=1'-0"

J JOINING MULLION
SCALE: 3"=1'-0"

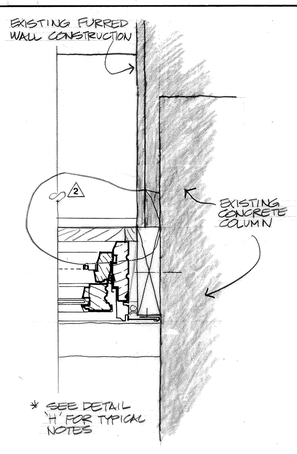

K TYPICAL CONCRETE JAMB
SCALE: 3"=1'-0"

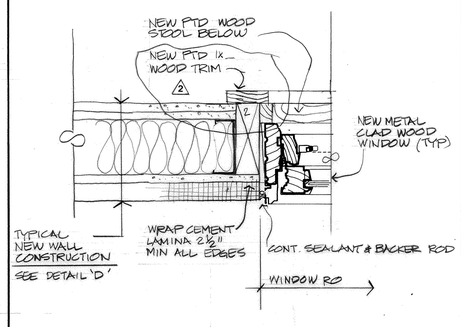

L NEW WALL CONSTRUCTION JAMB
SCALE: 3"=1'-0"

JAMES E. GALLIHER No. 526 REGISTERED ARCHITECT	NETC DWG NO. 22934-236	DEPARTMENT OF THE NAVY — NAVAL FACILITIES ENGINEERING COMMAND
	GALLIHER SCHOENHARDT & BAIER . ARCHITECTS SIMSBURY CONNECTICUT	NAVAL EDUCATION AND TRAINING CENTER NEWPORT, RHODE ISLAND
	DWN — DATE 28 Jan 1982 NO. 8205	EXTERIOR WALL IMPROVEMENTS BUILDING NO. 678 NAVAL COMPLEX, NEWPORT RHODE ISLAND
	PARTNER	WALL DETAILS
SATISFACTORY TO	PROJ MGR — ENG DIR	SIZE F — CODE IDENT NO. 80091 — NAVFAC DRAWING NO. 2060434
DATE 8-2-82	APPROVED CAPT CEC USN — OFFICER IN CHARGE — DATE 8-2-82	SCALE: AS INDICATED — CONSTR. CONTR. NO. N62472-82-C-1756 — SPEC 04-32-1756 — SHEET 4 OF 4