REVISION				
SYM	ZONE	DESCRIPTION	DATE	APPROVED
		AS BUILT 9-25-87 NO CHANGE	5-6-98	MD

ROOF REPLACEMENT FOR BUILDINGS NO. 441, NO. 444, AND NO. 678

N62472·86·C·1643

NAVAL EDUCATION AND TRAINING CENTER, NEWPORT, RHODE ISLAND

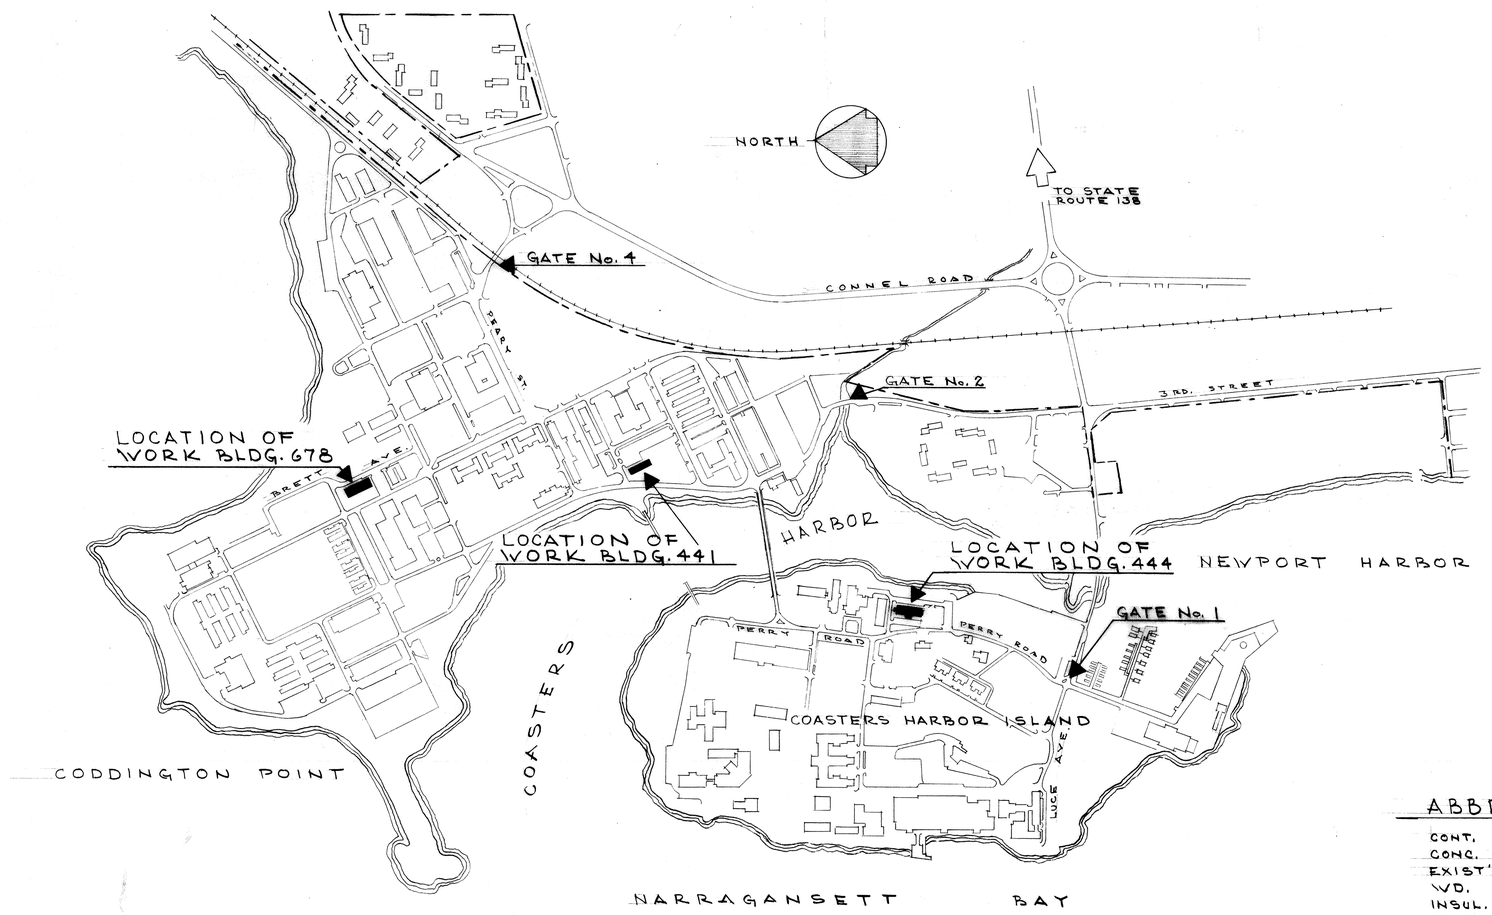

LOCATION PLAN

SCALE 1" = 400'

INDEX TO DRAWINGS

A1 TITLE SHEET

A2 BUILDING No. 441

A3 BUILDING No. 444

A4 BUILDING No. 678

A5 EXT. BLDG. ELEVATIONS & WIND LOAD RF. PLANS

ABBREVIATIONS

CONT.	CONTINUOUS
CONC.	CONCRETE
EXIST'G	EXISTING
WD.	WOOD
INSUL.	INSULATION
SQ.	SQUARE
ST.	STEEL
RF.	ROOF
O.C.	ON CENTERS
BLOCK'G	BLOCKING
MET.	METAL

OLIVER C. JOHNSON No 852 REGISTERED ARCHITECT

McLEISH & JOHNSON, ARCH.
655 MAIN ST. E. GREENWICH
RHODE ISLAND
DWN. J DATE 2-25-86
PARTNER [signature]

NETC DWG. NO. 25682-253
NETC SK. NO.
DSGN
DR.
BR. AW CHAPLIN 2/27/86
DIR. [signature] PE 3/3/86
APPROVED D.R. Shaffer DATE 3/6/86
SATISFACTORY TO
DATE

DEPARTMENT OF THE NAVY — NAVAL FACILITIES ENGINEERING COMMAND
NAVAL EDUCATION AND TRAINING CENTER
NEWPORT, RHODE ISLAND

ROOF REPLACEMENT FOR BUILDINGS No. 441, No. 444 & No. 678

LOCATION PLAN & INDEX TO DRAWINGS

SIZE	CODE IDENT NO.	NAVFAC DRAWING NO.	
F	80091	2098079	A1

CONSTR. CONTR. NO. N62472-86-C-1643
SCALE: AS SHOWN
SPEC. 04-86-1643
SHEET 1 OF 5