REVISION				
SYM	ZONE	DESCRIPTION	DATE	APPROVED
1		AS BUILT 9-25-87	5-6-98	MD

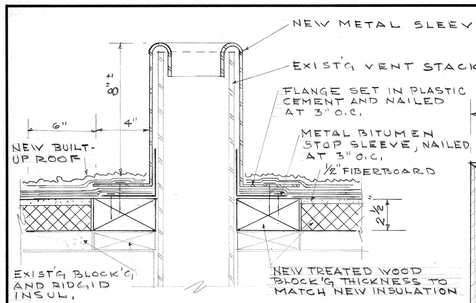

DETAIL OF ROOF VENT

SCALE 3"=1'-0"

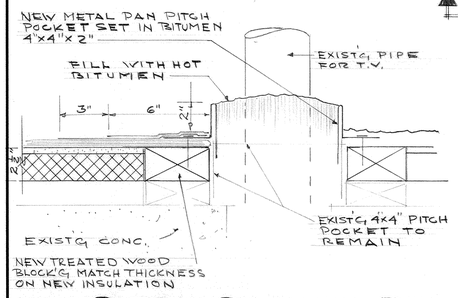

NEW PITCH POCKET DETAIL

SCALE 3"=1'-0"

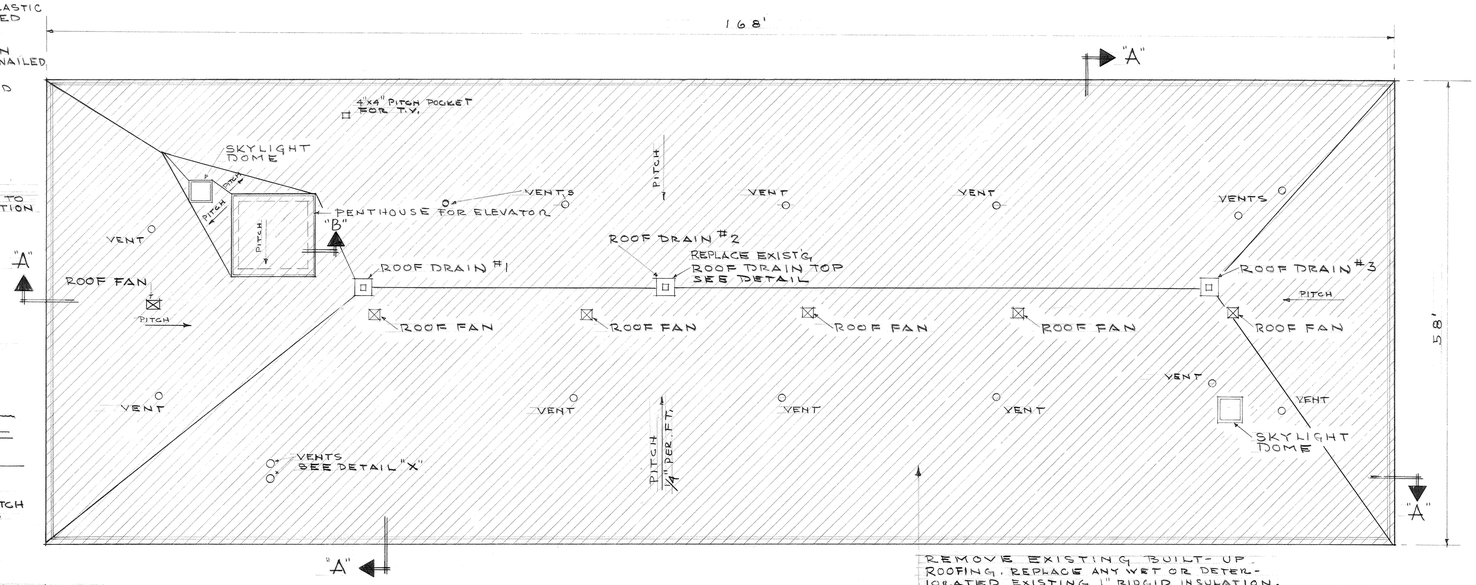

ROOF PLAN BUILDING No. 678

SCALE 1/8"=1'-0"

REMOVE EXISTING BUILT-UP ROOFING. REPLACE ANY WET OR DETERIORATED EXISTING 1" RIDGID INSULATION. ASSUME 500 S.F. FOR REPLACEMENT. PROVIDE NEW ADDITIONAL ROOF INSULATION, 1/2" FIBERBOARD, AND NEW BUILT-UP ROOF.

ROOF OF BUILDING IS APPROX. 47'± ABOVE GRADE.

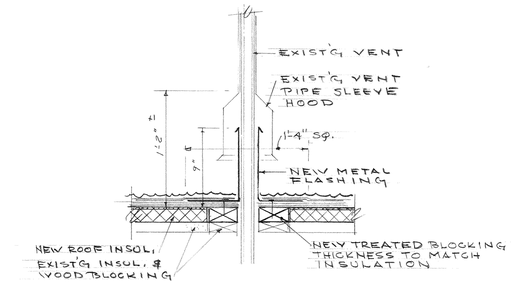

DETAIL "X" OF ROOF VENT

SCALE 1 1/2"=1'-0"

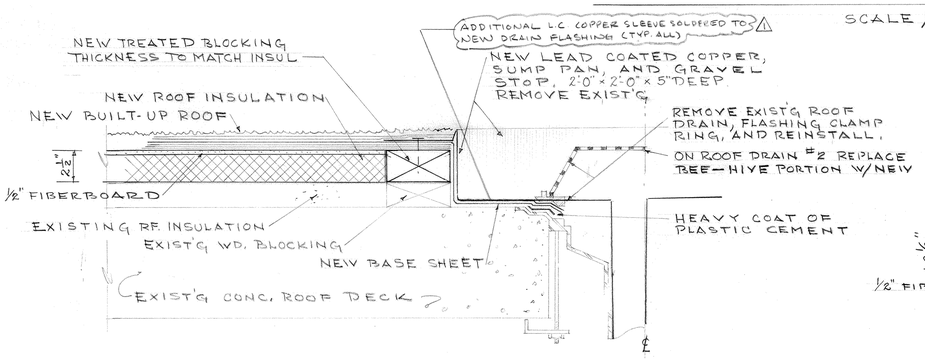

DETAIL OF ROOF DRAINS

SCALE 3"=1'-0"

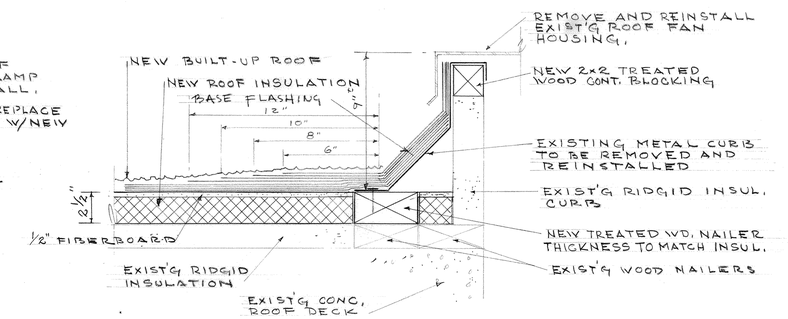

DETAIL OF ROOF FAN CURBING

SCALE 3"=1'-0"

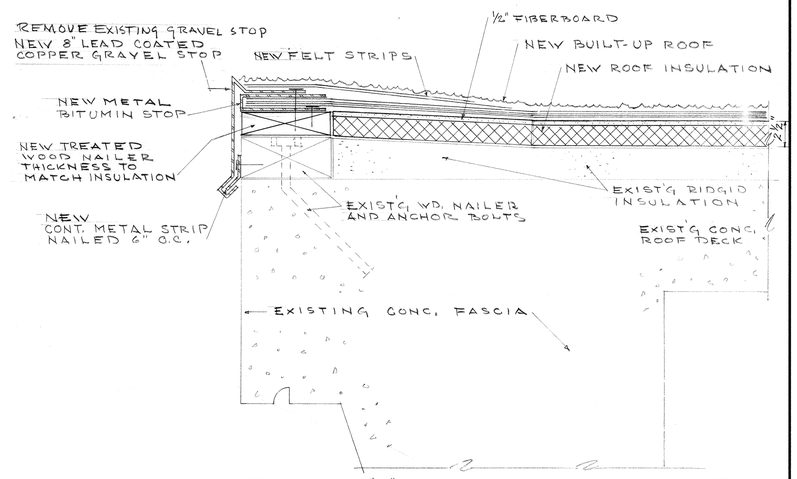

SECTION "A" THRU CORNICE

SCALE 3"=1'-0"

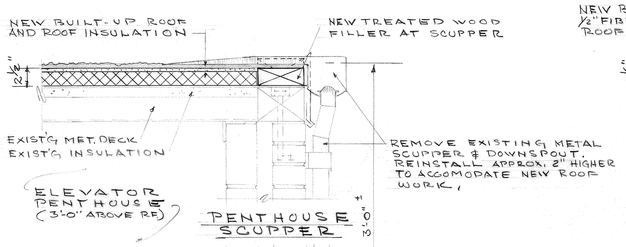

PENTHOUSE SCUPPER

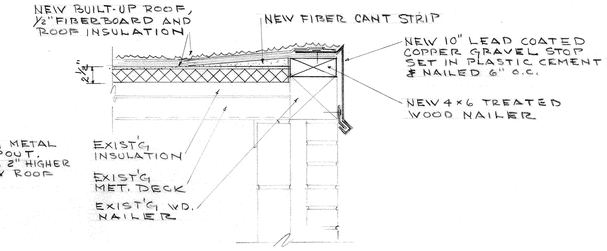

SECTION "B" THRU PENTHOUSE

SCALE 1 1/2"=1'-0"

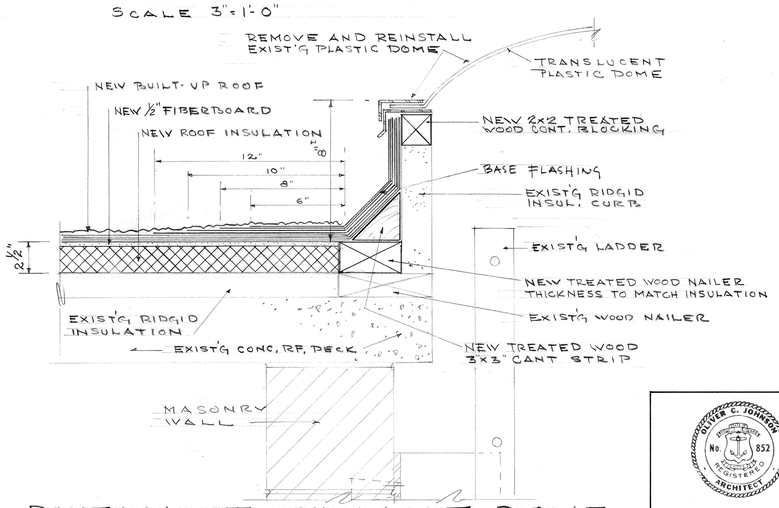

DETAIL AT SKYLIGHT DOME

SCALE 3"=1'-0"

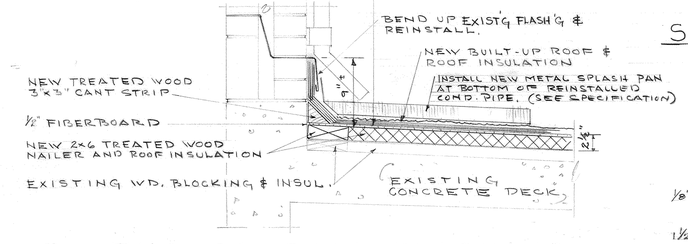

PENTHOUSE BASE FLASHING

SCALE 1 1/2"=1'-0"

GRAPHIC SCALES

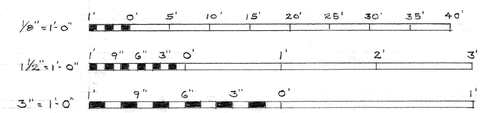

OLIVER G. JOHNSON No. 852 REGISTERED ARCHITECT	NETC DWG. NO. 25685-253	DEPARTMENT OF THE NAVY — NAVAL FACILITIES ENGINEERING COMMAND	
	NETC SK. NO.	NAVAL EDUCATION AND TRAINING CENTER NEWPORT, RHODE ISLAND	
	DSGN.	ROOF REPLACEMENT FOR BUILDINGS No. 441, No. 444 & No. 678	
	DR.		
	BR. LUCHAPUN 2/27/86		
	DIR. 3/6/86		
	APPROVED DATE 3/6/86	PLANS AND DETAILS BUILDING No. 678	
McLEISH & JOHNSON, ARCH. 655 MAIN ST. E. GREENWICH RHODE ISLAND	SATISFACTORY TO	SIZE F / CODE IDENT NO. 80091	NAVFAC DRAWING NO. 2098082 A4
DWN. DATE 2-25-86 PARTNER	DATE	SCALE: AS SHOWN	CONSTR. CONTR. NO. N62472-86-C-1643 SPEC 04-86-1693 SHEET 4 OF 5