REVISION				
SYM	ZONE	DESCRIPTION	DATE	APPROVED
		CORRECTED TO AS-BUILT CONDITION	4-10-90	AWC

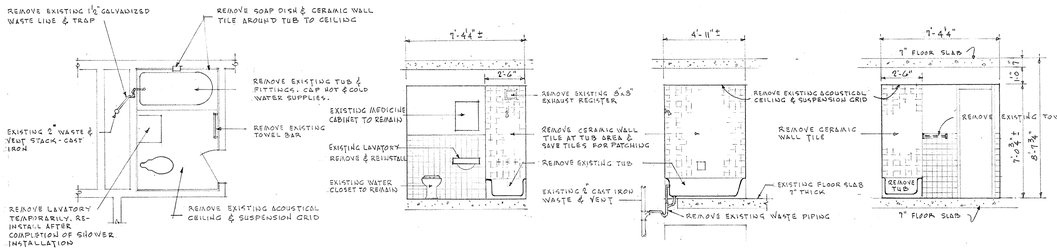

PLAN OF TYPICAL TOILET ROOM SCALE ¼" = 1'-0" WALL ELEVATIONS

DEMOLITION - ARCHITECTURAL

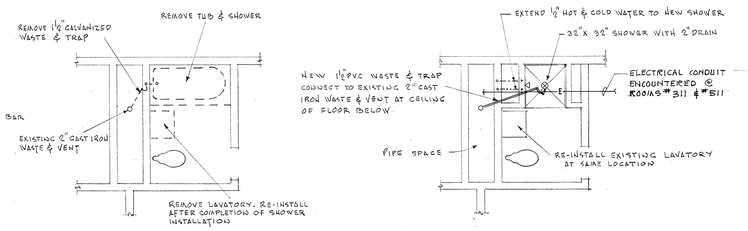

DEMOLITION SCALE ¼" = 1'-0" NEW WORK

PLUMBING

GENERAL NOTES

1. — ALL TOILET ROOMS ARE VERTICALLY STACKED.
2. — ALL WORK IS "TYPICAL" FOR EACH TOILET ROOM.
3. — FOR ACCESS TO AREA OF PLUMBING WORK FROM TOILET ROOM BELOW:
   - REMOVE & REINSTALL EXISTING ACOUSTICAL CEILING TILES & SUSPENSION SYSTEM AS REQUIRED, AND OTHER WORK WHICH IS ALSO NECESSARY TO DO
   - PROTECT ALL EXISTING SURFACES & PLUMBING FIXTURES

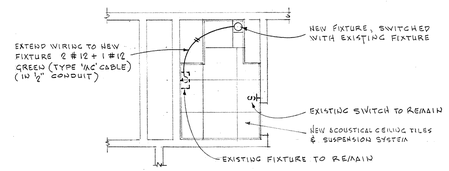

NEW FIXTURE

LAMP: 60 WATT INCANDESCENT

DESCRIPTION: RECESSED INCANDESCENT SHOWER LIGHT WITH GASKETED DROP OPAL LENSE, 120 VOLT

REFLECTED CEILING PLAN

SCALE ¼" = 1'-0"

ELECTRICAL

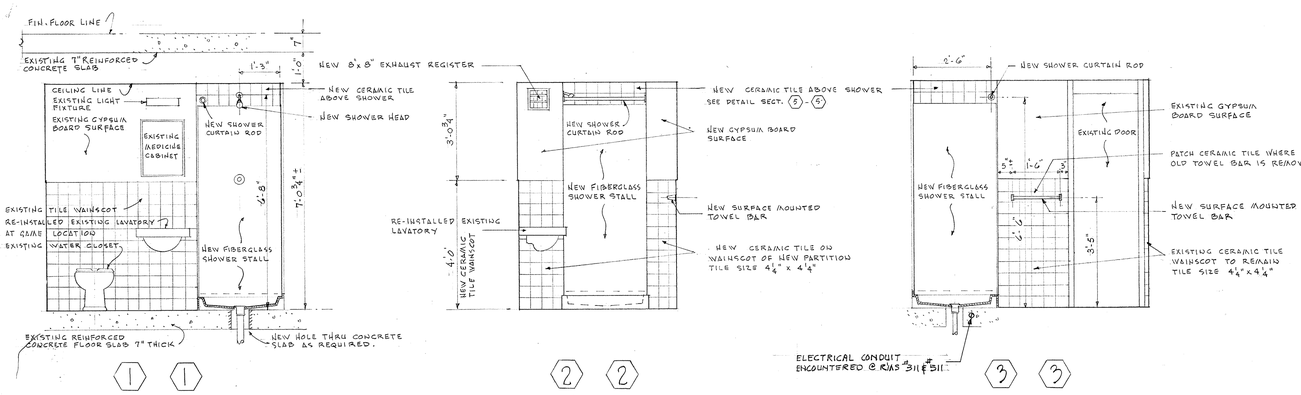

ELEVATIONS

SCALE ½" = 1'-0"

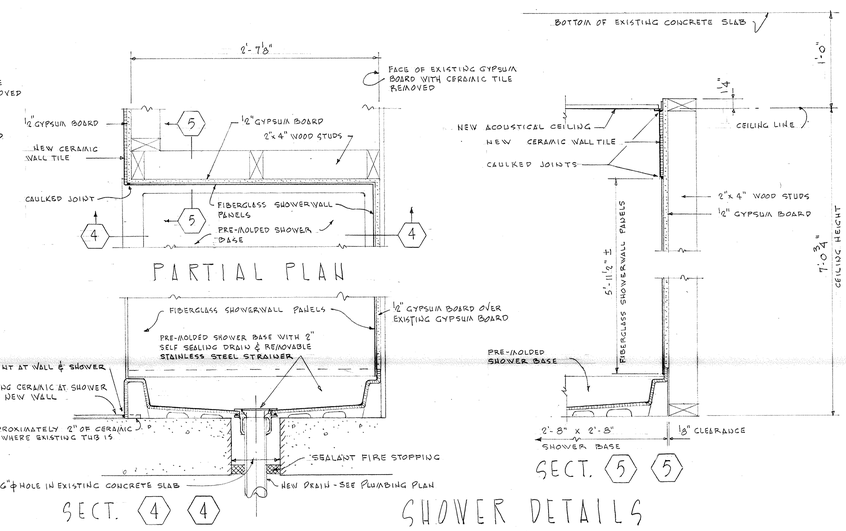

PARTIAL PLAN

SECT. 4 4

SECT. 5 5

SHOWER DETAILS

SCALE 1½" = 1'-0"

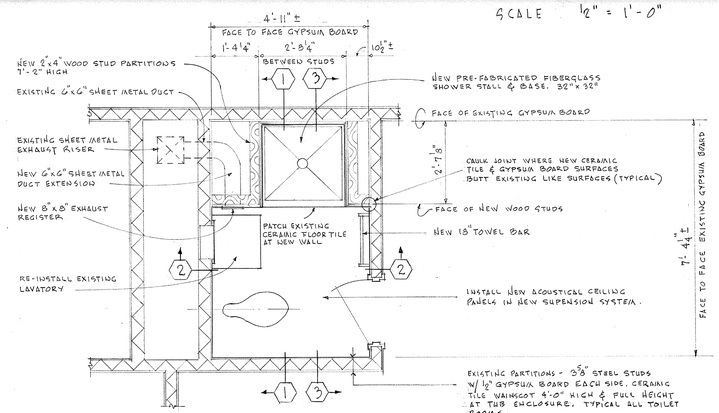

PLAN OF TYPICAL TOILET ROOM

SCALE ½" = 1'-0"

NEW SHOWER LOCATIONS

THIRD FLOOR: ROOMS 306, 311, 312, 315, 317, 319, 322, 327,
FIFTH FLOOR: ROOMS 501, 502, 509, 511, 513, 515, 516, 517, 521, 522, 527

NOTE - SOME ROOMS ARE AS SHOWN AND SOME ARE OPPOSITE HAND. CONTRACTOR TO FIELD CHECK.

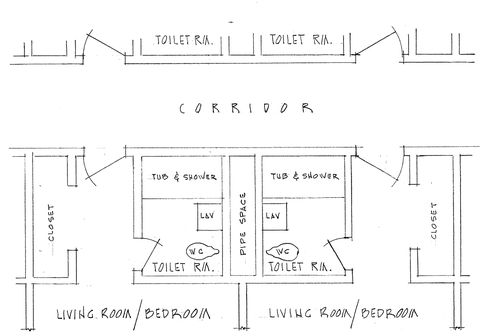

PLAN OF TYPICAL ROOM ARRANGEMENT

SCALE ¼" = 1'-0"

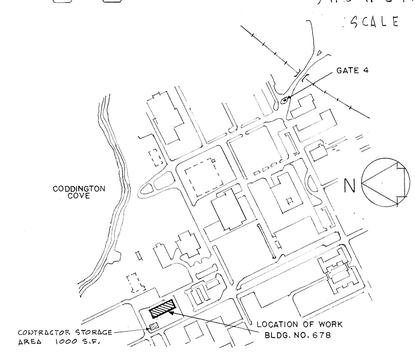

LOCATION PLAN VICINITY MAP

NOT TO SCALE

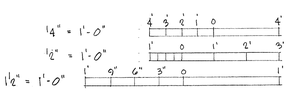

GRAPHIC SCALES

THOMAS DOYLE ALMY No. 452 REGISTERED ARCHITECT	NETC DWG. NO. 27796-271 I.T. ALMY ASSOCIATES ARCHITECT SOMERSET, MASSACHUSETTS DWN JWA DATE 6-26-89 NO. 8915	DEPARTMENT OF THE NAVY NAVAL FACILITIES ENGINEERING COMMAND **NAVAL EDUCATION AND TRAINING CENTER NEWPORT, RHODE ISLAND**	INSTALLATION OF SHOWERS BUILDING NO. 678 C.P.
SATISFACTORY TO DATE 6/29/89	PROJ MGR 10/27/89 ENG DIR APPROVED 10-30-89 OFFICER IN CHARGE DATE	SIZE F / CODE IDENT NO. 80091	NAVFAC DRAWING NO. 2124918
		SCALE: AS NOTED	CONSTR. CONTR. NO. N62472-89-C-1632 SPEC 04-89-1632 SHEET 1 OF 1