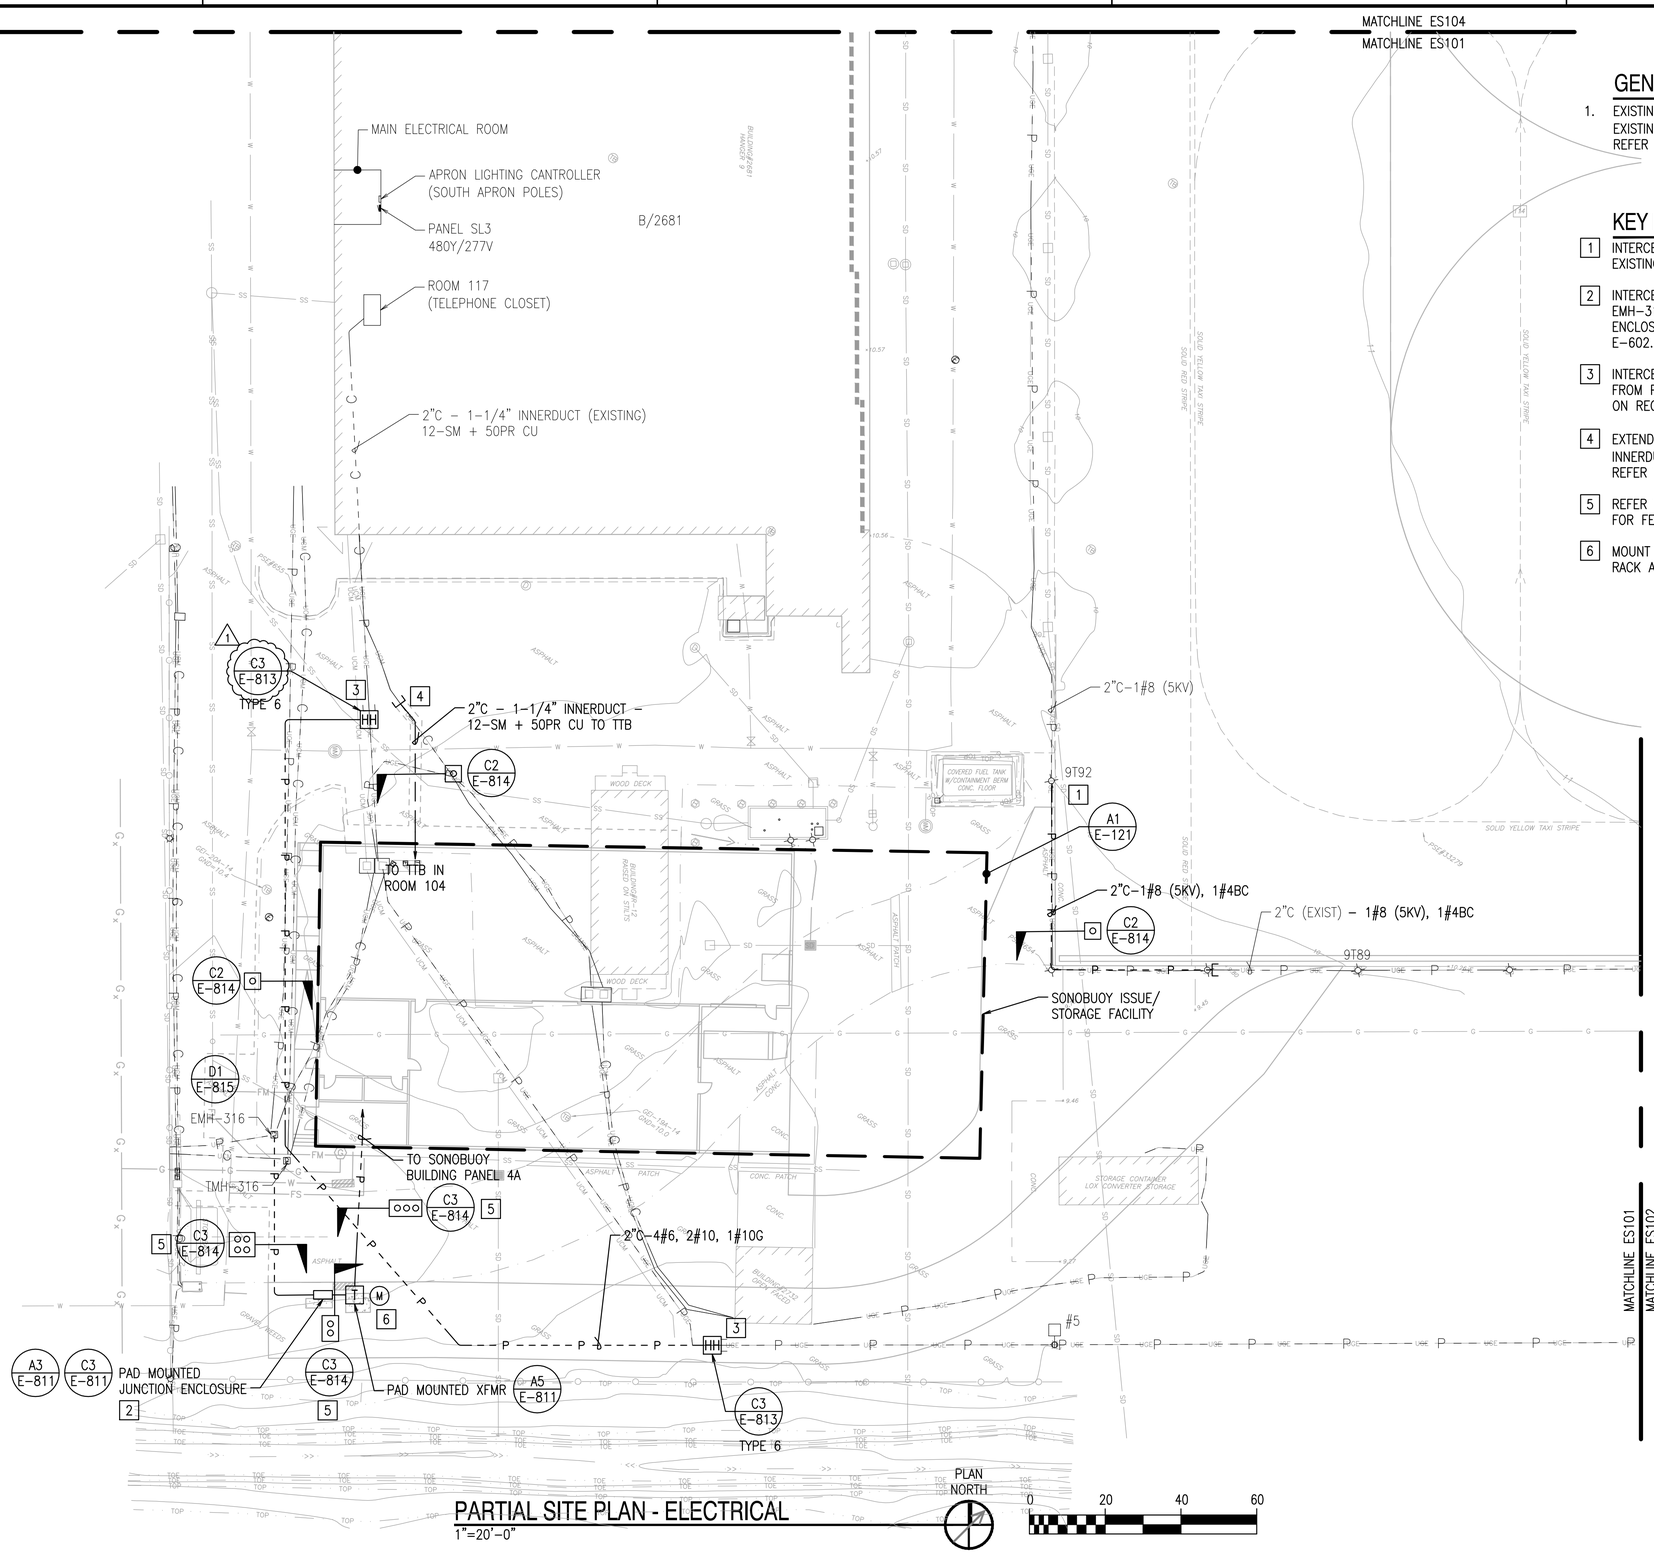

PARTIAL SITE PLAN - ELECTRICAL
1"=20'-0"

GENERAL SHEET NOTES:

1. EXISTING TAXIWAY/APPON EDGE LIGHTS ARE FED FROM AN EXISTING 6.6A VOLTAGE REGULATOR IN B368 (VAULT A). REFER TO G-001 FOR LOCATION OF B368.

KEY NOTES:

1. INTERCEPT EXISTING APRON EDGE LIGHTING CIRCUIT AT EXISTING LIGHT AND EXTEND TO REMAINING LIGHT 9T89.
2. INTERCEPT EXISTING FEEDER CU310-3 IN EXISTING MANHOLE EMH-316 AND EXTEND TO ABOVE GRADE JUNCTION ENCLOSURE. REFER TO POWER ONE-LINE DIAGRAM ON SHEET E-602.
3. INTERCEPT EXISTING SOUTH APRON POLE LIGHT CIRCUITS FROM PANEL SL3 IN B2681 AND EXTEND. INDICATE CIRCUITS ON RECORD DRAWINGS.
4. EXTEND 2" TELECOMMUNICATIONS CONDUIT AND 1-1/4" INNERDUCT TO TTB IN SONOBUOY ISSUE/STORAGE FACILITY. REFER TO SHEET E-321.
5. REFER TO ONE LINE DIAGRAM ON SHEETS E-602 AND E-621 FOR FEEDERS AND ADDITIONAL REQUIREMENTS.
6. MOUNT RELOCATED AMI POWER METER ON METAL STRUT RACK ADJACENT TO TRANSFORMER.

KEY PLAN

SYM	DESCRIPTION	DATE	APPR
1	AMENDMENT 005	3/27/15	GLL

NAVFAC

SEAL

SPARLING
WORK TOGETHER | STAND APART™
4100 194th Street SW, Suite 400
Lynnwood, Washington 98036-8613
206-667-0555 800-667-0610
www.sparling.com

A/E INFO

APPROVED

FOR COMMANDER NAVFAC

ACTIVITY: NAS WHIDBEY ISLAND

SATISFACTORY TO DATE

DES KMD DRW AM CHK GLL

<<PM/DM>> JOSEPH KISIDAY

BRANCH MANAGER

CHIEF ENG/ARCH

<<XXX>>

DEPARTMENT OF THE NAVY
NAVAL FACILITIES ENGINEERING COMMAND
NAVAL FACILITIES ENGINEERING COMMAND ~ NORTHWEST
NAVAL AIR STATION WHIDBEY ISLAND
AULT FIELD – OAK HARBOR, WA

OAK HARBOR, WA
FY-15 MCON PROJECT P-259 P-8A AIRCRAFT APRON EXPANSION - PART A

PARTIAL SITE PLAN – ELECTRICAL

SCALE: AS NOTED

EPROJECT NO.:

CONSTR. CONTR. NO.: N44255-15-C-6003

NAVFAC DRAWING NO.: 16030514

SHEET 260 OF 302

ES101

DRAWFORM REVISION: 10 MARCH 2009