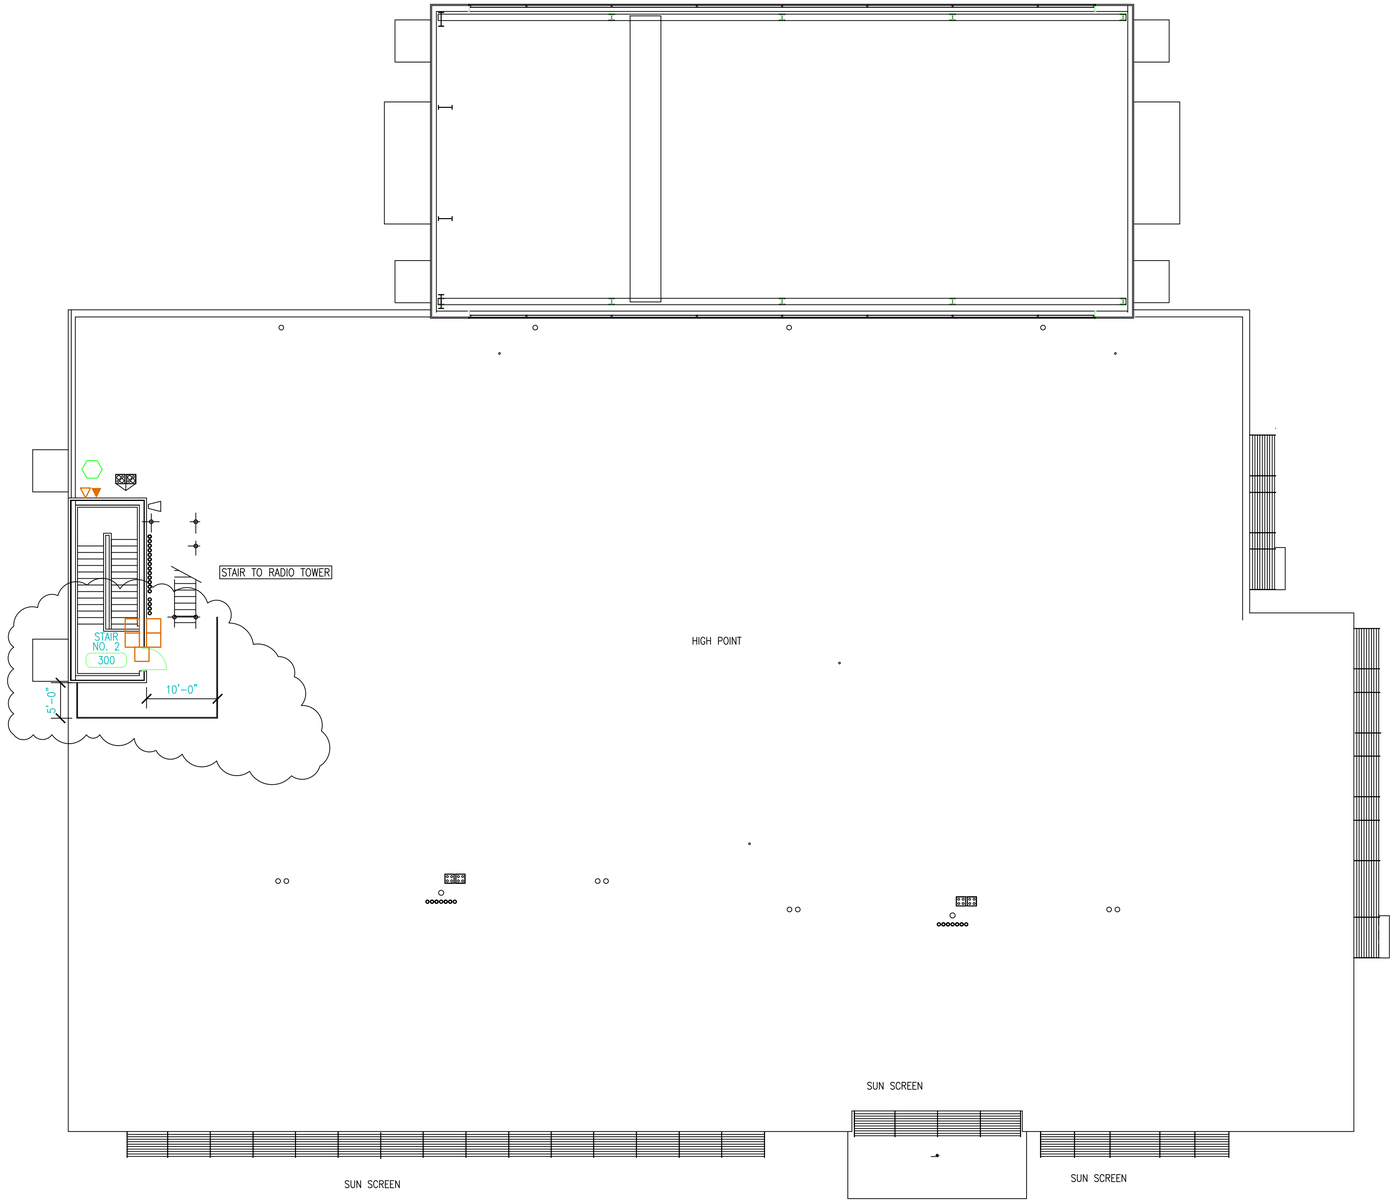


0 4' 8' 16'
SCALE: 3/32"=1'-0"

## LOWER ROOF PLAN

rwARMSTRONG
Burke Lakefront Airport
1501 N. Marginal Rd. / Suite 200
Cleveland, OH 44114
PH 216.443.1700 // FX 216.443.1780
rwArmstrong.com

COMPANY LOGO
.\tagline_center.jpg

REYNOLDS, SMITH & HILLS
DESIGNER: S. CONWAY DRAWN BY: A. MAY
REVIEWER: A. LEE
SUBMITTED BY:
NAVFAC BRANCH HEAD:
F.P.E.:

DRAWING REVISIONS

| REV. | DESCRIPTION | PREP BY | DATE | APPRVD. |
|---|---|---|---|---|
| | | | | |

NAVAL SUPPORT ACTIVITY
PANAMA CITY, FLORIDA

P-388 LITTORAL WARFARE SYSTEMS FACILITY
LOWER ROOF PLAN

APPROVED DATE
ACTIVITY, FOR COMMANDING OFFICER
APPROVED DATE
FTD, FOR COMMANDER, NAVFAC

NAVFAC Naval Facilities Engineering Command
NAVFAC SOUTHEAST

RECORD DRAWING DATE XX-XXX-20XX
CODE I.D. NO. 80091
DRAWING SIZE: D
WON NO. 536684
CONSTRN. CONTR. NO. N62467-03-D-0188-006
NAVFAC DRAWING NO. 15017904
SHEET 139 OF 144
T-103