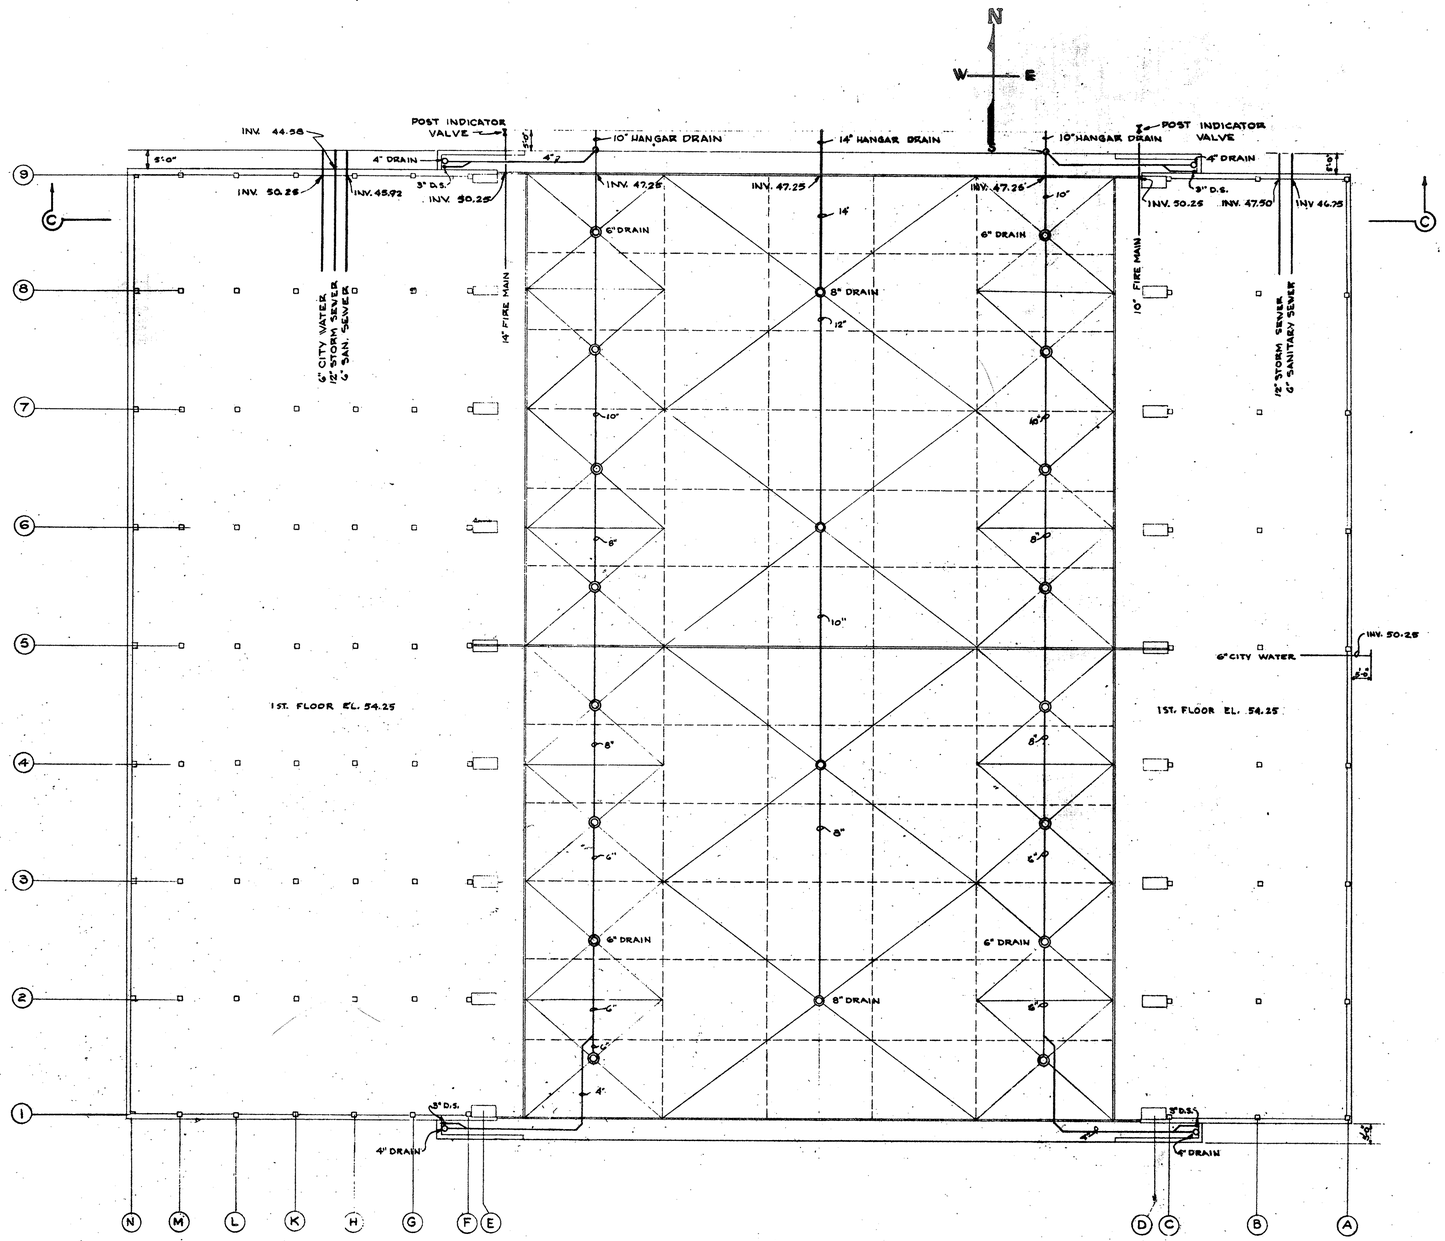

HANGAR UTILITIES PLAN

SCALE: 1/16" = 1'-0"

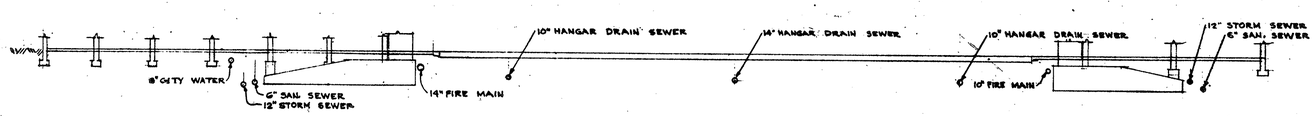

SECTION C-C

SCALE: 1/16" = 1'-0"

GRAPHIC SCALE

1/16" = 1'-0" 0 16 32 48 64 80 96

VENTILATION & PLUMBING SYMBOLS

	WASTE, SOIL & STORM SEWER
	VENT PIPING
	COLD WATER PIPING
	HOT WATER PIPING
	HOT WATER RECIRCULATING LINE
—A—	AIR PIPING
—V—	VACUUM PIPING
F.D.	FLOOR DRAIN
R.D.	ROOF DRAIN
F.H.R.	FIRE HOSE RACK
D.S.	DOWNSPOUT
C.O.	CLEANOUT (FLUSH WITH FLOOR)
A.P.	ACCESS PANEL
—A	AIR OUTLET
—W	2" HOSE OUTLET IN HANGAR
—HC	HOT & COLD WATER MIXING VALVE & OUTLET
W.S.	WASTE STACK
S.S.	SOIL STACK
	GATE VALVE
	GLOBE VALVE
	CHECK VALVE
	SUPPLY DUCT
	RETURN OR EXHAUST DUCT
	DUCT (WIDTH & DEPTH)

RECORD DRAWING

SHEET ___ OF ___

SEE LETTER NO. ___ DATED ___

SYMBOL	DESCRIPTION	DATE	APPROVAL
A	AS BUILT CONDITIONS	1 FEB 1955	Paul Bylee
1	REVISED Y.&D. DWG. No. TO 545889	SEP. 29 52	H.J.M.

REVISIONS

DEPARTMENT OF THE NAVY — BUREAU OF YARDS & DOCKS — WASHINGTON, D. C.
ROBERTS & SCHAEFER CO. — NEW YORK, N. Y. — CONSULTING ENGINEERS
KARSUNKY WELLER & GOOCH — WASHINGTON, D. C. — MECHANICAL ENGINEERS

DRAWN BY RWC
CHECKED BY WKK
DIRECTED BY
R.O. IN C.C.

LAND PLANE HANGAR
N.A.S. LEEWARD POINT
GUANTANAMO, CUBA

MECHANICAL PLAN - HANGAR UTILITIES

APPROVED H. L. Matthews OFFICER IN CHARGE — DATE SEP 11 1952

APPROVED FOR BUREAU OF YARDS & DOCKS
FOR CHIEF OF BUREAU
DATE SEP 22 1952

SCALE AS NOTED — STD. SPEC. NO. 33474
SHEET 41 OF 61
Y. & D. DRAWING NO. 545889 (1)